


WELL PLUGGING RECORD

Give All Information Completely  
Make Required Affidavit  
Mail or Deliver Report to:  
Conservation Division  
State Corporation Commission  
211 No. Broadway  
Wichita, Kansas

Harper County, Sec. 9 Twp. 33 Rge. 7 (X) W (W)

Location as "NE/CNW&SW" or footage from lines NE NE NW  
Lease Owner Graybol Oil Corporation  
Lease Name Bluhm Well No. 1  
Office Address 425 N.B.T. Bldg., Tulsa, Oklahoma  
Character of Well (completed as Oil, Gas or Dry Hole) Dry  
Date well completed 11/25/56 19  
Application for plugging filed 11/28/56 19  
Application for plugging approved 11/26/56 19  
Plugging commenced 11/25/56 19  
Plugging completed 11/25/56 19  
Reason for abandonment of well or producing formation Dry

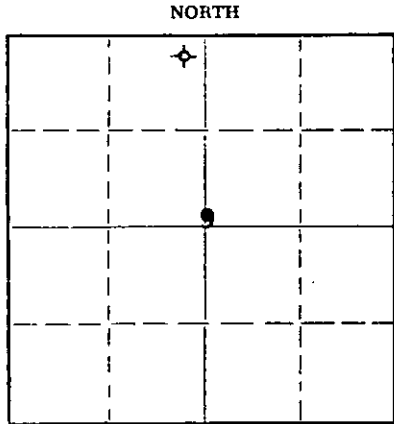

Locate well correctly on above Section Plat

If a producing well is abandoned, date of last production \_\_\_\_\_ 19\_\_\_\_  
Was permission obtained from the Conservation Division or its agents before plugging was commenced? yes

Name of Conservation Agent who supervised plugging of this well M. A. Rives  
Producing formation None Depth to top \_\_\_\_\_ Bottom \_\_\_\_\_ Total Depth of Well 5165 Feet  
Show depth and thickness of all water, oil and gas formations.

OIL, GAS OR WATER RECORDS

CASING RECORD

FORMATION	CONTENT	FROM	TO	SIZE	PUT IN	PULLED OUT
<u>Stalnaker</u>	<u>Dry</u>	<u>3646</u>	<u>3799</u>	<u>8 5/8"</u>	<u>246'</u>	<u>None</u>
<u>Kansas City</u>	<u>Dry</u>	<u>2932</u>	<u>4130</u>			
<u>Mississippian</u>	<u>Dry</u>	<u>4495</u>	<u>4836</u>			
<u>Viola</u>	<u>Dry</u>	<u>4933</u>	<u>4950</u>			
<u>Simpson</u>	<u>Dry</u>	<u>4950</u>	<u>5131</u>			
<u>Arbuckle</u>	<u>Dry</u>	<u>5131</u>	<u>5165, T.D.</u>			

Describe in detail the manner in which the well was plugged, indicating where the mud fluid was placed and the method or methods used in introducing it into the hole. If cement or other plugs were used, state the character of same and depth placed, from \_\_\_\_\_ feet to \_\_\_\_\_ feet for each plug set.

Hole filled with heavy mud to 230'  
1/2 sack hulls and 25 sacks \* @ 230' \*Cement  
filled with mud to 35'  
35' to surface with 10 sacks cement

RECEIVED  
STATE CORPORATION COMMISSION  
DEC 5 - 1956  
CONSERVATION DIVISION  
Wichita, Kansas

(If additional description is necessary, use BACK of this sheet)

Name of Plugging Contractor Graybol Oil Corporation  
Address 425 National Bank of Tulsa Building, Tulsa, Oklahoma

STATE OF Oklahoma, COUNTY OF Tulsa, ss.  
A. N. Ward (employee of owner) or (owner or operator) of the above-described well, being first duly sworn on oath, says: That I have knowledge of the facts, statements, and matters herein contained and the log of the above-described well as filed and that the same are true and correct. So help me God.

(Signature) [Signature]  
(Address) \_\_\_\_\_

SUBSCRIBED AND SWORN TO before me this 28 day of November, 19 56

My commission expires July 21, 1958 Madison J. Barton Notary Public.

PLUGGING  
FILE SEC 9 T. 33 R. 7W  
BOOK PAGE 119 L. E. 20

file

GRAYBOL OIL CORPORATION

Harper County, Kansas

BLUHM No. 1

Sec. 9, Twp. 33S, Rge. 7W

CONTRACTOR: Company Tools

Elev: 1354 D. F.

DRILLING COMMENCED: 10-18-56

11-24-56

Production: Dry hole.

CASING RECORD

Run	Cement	Pulled
246' 8 5/8"	125 sacks	None

DEPTH	STRATA	FORMATION TOPS:	DEPTH
0 - 260	Surface	Heebner	3322
260 - 1070	Shale and red beds	Douglas	3431
1070 - 1300	Lime, shale and red beds	Stainaker	3646
1300 - 1830	Lime and shale	Kansas City	3932
1830 - 1900	Lime	Marmaton	4130
1900 - 1995	Shale	Cherokee	4386
1995 - 2115	Lime and shale	Mississippian	4495
2115 - 2250	Shale	Kinderhook	4836
2250 - 2420	Shale and lime streaks	Chattanooga	4904
2420 - 2575	Lime and shale	Viola	4933
2575 - 2675	Shale	Simpson	4950
2675 - 2850	Shale and lime streaks	Arbuckle	5131
2850 - 2995	Shale and lime		
2995 - 3100	Shale		
3100 - 3315	Shale and lime		
3315 - 3410	Shale		
3410 - 3545	Shale and lime		
3545 - 3615	Shale		
3615 - 3828	Shale and lime		
3828 - 3876	Lime, shale and sand		
3876 - 3961	Shale and lime		
3961 - 3994	Shale		
3994 - 4042	Lime and shale		
4042 - 4175	Lime		
4175 - 4246	Shale		
4246 - 4278	Lime and shale		
4278 - 4323	Lime		
4323 - 4386	Limy shale		
4386 - 4494	Lime and shale		
4494 - 4841	Lime		
4841 - 4905	Shale		
4905 - 4947	Lime		
4947 - 5015	Sand		
5015 - 5025	Sand and shale		
5025 - 5048	Sand		
5048 - 5082	Lime and sand		
5082 - 5132	Lime, sand and shale		
5132 - 5165	Lime		
5165	Total Depth		

No showings were encountered and no cores or drill-stem tests were taken.

RECEIVED  
STATE CORPORATION COMMISSION  
DEC 1 - 1956  
CONSERVATION DIVISION  
Wichita, Kansas

I hereby certify that the above is a true and correct log-of said well as reflected by the daily drilling reports.

PLUGGING  
FILE SEC 9 T 33 R 7W  
BOOK PAGE 119 LINE 20

GRAYBOL OIL CORPORATION

By: Jack Cole  
Jack Cole, Geologist

STATE OF OKLAHOMA, COUNTY OF TULSA, ss

Subscribed and sworn to before me this 30<sup>th</sup> day of November, 1956.

Medford J. Barton  
Notary Public

My commission expires July 21, 1958.