


WELL PLUGGING RECORD

Give All Information Completely  
Make Required Affidavit  
Mail or Deliver Report to:  
Conservation Division  
State Corporation Commission  
800 Bitting Building  
Wichita, Kansas

NORTH

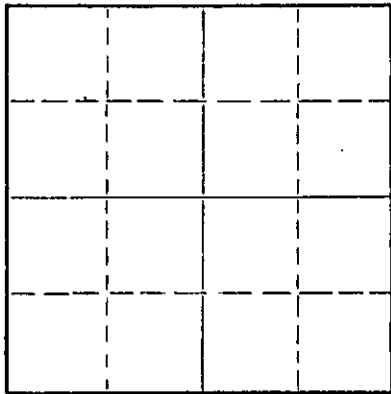

Locate well correctly on above  
Section Plat

Harper County, Sec. 2 Twp. 33 Rge. (E) 8 (W)  
Location as "NE/CNW&SW&" or footage from lines SW NW SE  
Lease Owner Rupp-Ferguson Oil Co.  
Lease Name McKaig Well No. 1  
Office Address 522 Union Center, Wichita, Kansas  
Character of Well (completed as Oil, Gas or Dry Hole) Dry Hole  
Date well completed 9-23-56 19  
Application for plugging filed 9-23-56 19  
Application for plugging approved 9-23-56 19  
Plugging commenced 9-23-56 19  
Plugging completed 9-23-56 19  
Reason for abandonment of well or producing formation

If a producing well is abandoned, date of last production 19  
Was permission obtained from the Conservation Division or its agents before plugging was commenced?

Name of Conservation Agent who supervised plugging of this well M. A. Rives  
Producing formation Depth to top Bottom Total Depth of Well 4935 Feet  
Show depth and thickness of all water, oil and gas formations.

OIL, GAS OR WATER RECORDS

CASING RECORD

FORMATION	CONTENT	FROM	TO	SIZE	PUT IN	PULLED OUT
				8 5/8	234'	0

Describe in detail the manner in which the well was plugged, indicating where the mud fluid was placed and the method or methods used in introducing it into the hole. If cement or other plugs were used, state the character of same and depth placed, from feet to feet for each plug set.

Circ., mud to 230', hulls, plug, 20 sacks cement. Mud to 35', hulls, plug, hulls. Cement to base of cellar.

(If additional description is necessary, use BACK of this sheet)

Name of Plugging Contractor Rupp-Ferguson Oil Co.  
Address 522 Union Center, Wichita, Kansas

STATE OF Kansas, COUNTY OF Sedgwick, ss.  
L. W. Knox (employee of owner) of the above-described well, being first duly sworn on oath, says: That I have knowledge of the facts, statements, and matters herein contained and the log of the above-described well as filed and that the same are true and correct. So help me God.

(Signature) *L. W. Knox*  
522 Union Center, Wichita, Kansas  
(Address)

SUBSCRIBED AND SWORN TO before me this 24th day of September, 19 56

My commission expires June 4, 1959 Notary Public.

PLUGGING  
FILE SEC. 2 T. 33 R. 8W  
BOOK PAGE 102 LINE 4

9-25-56

Contractor's Well Log

Rupp-Ferguson No. 1 McKaig  
SW NW 38, Sec. 2-33-8W,  
Harper County, Kansas

Elevation 1392 RB  
D & A

Commenced: 9-6-58  
Completed: 9-23-58  
Contractor: Rupp-Ferguson Oil Co.

Set 234' of 8 5/8" surface casing w/200 sacks cement

Figures Indicate Bottom of Formation

240 red bed & rock  
285 Anhydrite  
347 red bed  
390 shale & shells  
910 red bed & shale  
1100 salt  
1255 lime & shale  
1445 lime & shale streaks  
1720 lime  
2350 shale & lime  
2535 shale  
3439 lime & shale  
3545 sand, lime & shale  
3600 lime & shale  
3710 lime, shale & sand  
3790 sand  
3858 lime & shale  
3950 shale  
4005 shale & lime  
4132 lime  
4347 lime & shale  
4400 lime  
4495 lime & shale  
4771 Miss.  
4795 cherty lime & shale  
4858 shale  
4887 lime & chert  
4920 cherty lime & shale  
4935 T.D.

STATE OF KANSAS)  
SEDGWICK COUNTY) 83:

I, L. W. Knox, Landman for Rupp-Ferguson Oil Co., do hereby certify that the above and foregoing is a true and correct copy of the log of the No. 1 McKaig well.

PLUGGING			
FILE	SEC. 2	T 33	R 8W
BOOK	PAGE 102	LINE	4

L. W. Knox  
L. W. Knox

Subscribed and sworn to before me this 24th day of September, 1958.

Helen Horine  
Notary Public

My Commission Expires June 4, 1959.