


Give All Information Completely
Make Required Affidavit
Mail or Deliver Report to:
Conservation Division
State Corporation Commission
212 No. Market
Wichita, Kansas

WELL PLUGGING RECORD

NORTH

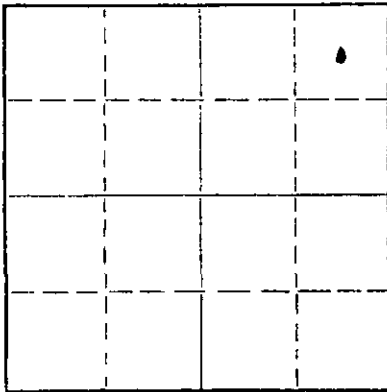

Locate well correctly on above
Section Plat

Harper

County, Sec. 16

Twp. 33S Rge. 7E

(E) (W)

Location as "NE/CNW/SW" or footage from lines

Lease Owner

Lee Phillips Oil Co.

Lease Name

Blasdel

Well No. 1

Office Address

1532 Wichita Plaza, Wichita, Kansas

Character of Well (completed as Oil, Gas or Dry Hole)

Dry Hole

Date well completed

12-7 1967

Application for plugging filed

12-7 1967

Application for plugging approved

12-7 1967

Plugging commenced

12-7 1967

Plugging completed

12-7 1967

Reason for abandonment of well or producing formation

Dry Hole

If a producing well is abandoned, date of last production

19

Was permission obtained from the Conservation Division or its agents before plugging was commenced? Yes

Name of Conservation Agent who supervised plugging of this well Archie Elving

Producing formation

Depth to top

Bottom

Total Depth of Well

Feet

Show depth and thickness of all water, oil and gas formations.

OIL, GAS OR WATER RECORDS

CASING RECORD

FORMATION	CONTENT	FROM	TO	SIZE	PUT IN	PULLED OUT
Surface pipe		-0-	210	8 5/8	210	None

Describe in detail the manner in which the well was plugged, indicating where the mud fluid was placed and the method or methods used in introducing it into the hole. If cement or other plugs were used, state the character of same and depth placed, from feet to feet for each plug set.

Filled hole with heavy mud.

#1 plug @ 200' with 25 sks. cement

#2 plug @ 40' with 10 sks. cement

#3 plug in rat hole with 2 sks. cement

RECEIVED
DECEMBER 14 1967

CONSERVATION DIVISION
STATE OF KANSAS

Name of Plugging Contractor Sweetman Drilling, Inc. (If additional description is necessary, use BACK of this sheet)

Address Box 645, Great Bend, Kansas 67530

STATE OF Kansas

COUNTY OF Barton

T. D. Sweetman

(employee of owner) or (owner or operator) of the above-described

well, being first duly sworn on oath, says: That I have knowledge of the facts, statements, and matters herein contained and the log of the above-described well as filed and that the same are true and correct. So help me God.


(Signature)

T. D. Sweetman

Box 645, Great Bend, Kansas 67530

(Address)

Subscribed and sworn to before me this 11 day of Dec., 1967

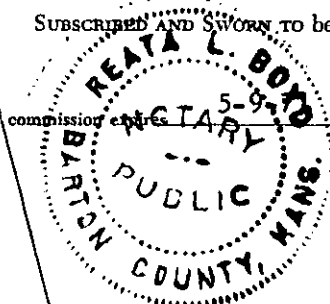

Reata L. Boyd

Notary Public.

WELL LOG
Blasdel #1
C NE NE 16-33S-7W
Harper County, Kansas

<u>FROM</u>	<u>TO</u>	
0	50	Red Rock
50	210	Red Bed
210	2150	Shale & Lime
2150	2467	Shale
2467	3130	Lime & Shale
3130	3650	Shale & Lime
3650	3800	Sand & Shale
3800	3955	Lime & Shale
3955	4156	Lime
4156	4380	Lime & Shale
4380	4503	Shale & Lime
4503	4639	Lime
4639	4687	Lime & Shale
4687	4831	Lime
4831	4931	Shale
4931	4964	Lime & Shale
4964	4980	Sand
4980		Total Depth

Elevation: 1345' K.B.

STATE OF KANSAS

COUNTY OF BARTON ss

T. D. Sweetman, Partner of Sweetman Drilling, Inc., being first duly sworn on oath says: That I have knowledge of the facts, statements and matters herein contained and the log of the above described well as filed and that the same are true and correct.

T. D. Sweetman
T. D. Sweetman

Subscribed and sworn before me this 11th day of December, 1967.

Reata L. Boyd
Notary Public Barton County

My Commission Expires 5-9-71

