

STATE OF KANSAS
STATE CORPORATION COMMISSION

Form CP-4


Give All Information Completely
Make Required Affidavit
Mail or Deliver Report to:
Conservation Division
State Corporation Commission
212 No. Market
Wichita, Kansas

WELL PLUGGING RECORD

Harper County, Sec. 30 Twp. 33S Rge. 8W (X) (W)

Location as "NE/CNW/SW" or footage from lines C NW NE
Lease Owner W. C. Pickens
Lease Name Hayes Well No. 1
Office Address 2000 Fidelity Union Tower, Dallas, Texas
Character of Well (completed as Oil, Gas or Dry Hole) Dry Hole
Date well completed 12-4-66 19
Application for plugging filed 12-4-66 19
Application for plugging approved 12-4-66 19
Plugging commenced 12-4-66 19
Plugging completed 12-4-66 19
Reason for abandonment of well or producing formation Dry Hole

NORTH

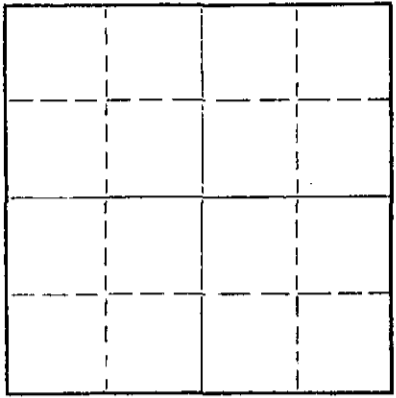

Locate well correctly on above Section Plat

If a producing well is abandoned, date of last production 19
Was permission obtained from the Conservation Division or its agents before plugging was commenced? yes

Name of Conservation Agent who supervised plugging of this well Archie Elving
Producing formation Depth to top Bottom Total Depth of Well 4937 Feet
Show depth and thickness of all water, oil and gas formations.

OIL, GAS OR WATER RECORDS

CASING RECORD

FORMATION	CONTENT	FROM	TO	SIZE	PUT IN	PULLED OUT
				8 5/8"	279'	none

Describe in detail the manner in which the well was plugged, indicating where the mud fluid was placed and the method or methods used in introducing it into the hole. If cement or other plugs were used, state the character of same and depth placed, from feet to feet for each plug set.

Bottom plug set @ 260' with 1/2 sk. hulls, 2 sks. dry cement and 23 sacks cem..
Top plug set @ 40' with 1/2 sack hulls, 10 sacks cement Job completed @ 7:00 a.m. 12-4-66

RECEIVED
STATE CORPORATION COMMISSION
DEC 8 1966
CONSERVATION DIVISION
Wichita, Kansas

(If additional description is necessary, use BACK of this sheet)

Name of Plugging Contractor Leben Drilling, Inc.
Address Box 486, Great Bend, Kansas 67530

STATE OF KANSAS, COUNTY OF BARTON, ss.
Leslie Kite (employee of owner) or (owner or operator) of the above-described

well, being first duly sworn on oath, says: That I have knowledge of the facts, statements, and matters herein contained and the log of the above-described well as filed and that the same are true and correct. So help me God.

(Signature) Leslie Kite

Box 486, Great Bend, Kansas 67530 (Address)

SUBSCRIBED AND SWORN TO before me this 7th day of December, 19 66

My commission expires April 1, 1967
Ulanda Nichols Notary Public.

DRILLER'S LOG

COMPANY: W. C. Pickens
 CONTRACTOR: LEBEN DRILLING, INC.
 FARM: HAYES #1
 LOCATION: C NW NE SEC. 30-33S-8W
 HARPER COUNTY, KANSAS
 COMMENCED: 11-21-66
 COMPLETED: 12-4-66

RECEIVED
STATE CONSERVATION COMMISSION

DEC 8 1966

CONSERVATION DIVISION
Wichita, Kansas

0	675	Redbed
675	1290	Shale
1290	1330	Anhydrite
1330	1645	Lime, Shale
1645	1855	Lime, Sand
1855	2090	Lime, Shale
2090	2410	Shale, Lime
2410	3295	Lime, Shale
3295	3535	Lime, Shale, Sand
3535	3705	Lime, Shale
3705	3810	Sand
3810	3854	Shale, Lime
3854	3963	Lime, Shale
3963	4420	Kansas City Lime
4420	4482	Lime, Shale
4482	4498	Chert, Lime
4498	4773	Lime
4773	4828	Lime, Shale
4828	4865	Lime
4865	4888	Lime, Chert
4888	4935	Lime, Sand
4935	4937	Simpson Sand
	<u>4937</u>	<u>RTD - D. & A.</u>

8 5/8" 20# new surface casing set @ 279' cemented with 210 sacks
Common, 2% cc

I, Leslie Kite, do hereby certify that the above and foregoing is a true and correct copy of the log of the Hayes #1 Well, located C NW NE of Section 30, Township 33 South, Range 8 West, Harper County, Kansas, as reflected by the records of Leben Drilling, Inc.

Leslie Kite

Leslie Kite

STATE OF KANSAS)
) SS
COUNTY OF BARTON)

Subscribed and sworn to and before me, a Notary Public, in and for Barton County, Kansas, this 7th day of December, 1966.

Ulanda Nichols

Ulanda Nichols

My Commission Expires: April 1, 1967