


WELL PLUGGING RECORD

Give All Information Completely  
Make Required Affidavit  
Mail or Deliver Report to:  
Conservation Division  
State Corporation Commission  
212 No. Market  
Wichita, Kansas

NORTH

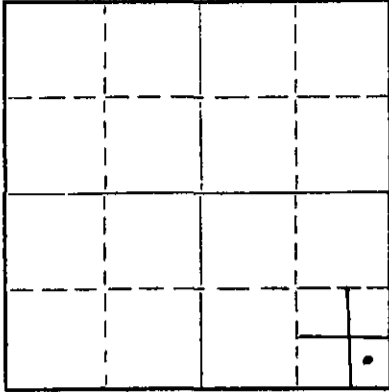

Locate well correctly on above  
Section Plat

Barber County. Sec. 21 Twp. 31S Rge. 11 (E) (W)  
Location as "NE/CNW/SE" or footage from lines SE/4, SE/4, SE/4  
Lease Owner Western Oil Fields, Inc.  
Lease Name Chain Well No. 1  
Office Address P.O. Box 1137, Hobbs, New Mexico  
Character of Well (completed as Oil, Gas or Dry Hole) Gas  
Date well completed September 12, 19 54  
Application for plugging filed June 13, 19 66  
Application for plugging approved June, 15, 19 66  
Plugging commenced June 24, 19 66  
Plugging completed June 29, 3:30 P.M. 19 66  
Reason for abandonment of well or producing formation Uneconomic to produce

If a producing well is abandoned, date of last production April 19 66  
Was permission obtained from the Conservation Division or its agents before plugging was commenced? Yes

Name of Conservation Agent who supervised plugging of this well Archie Elving  
Producing formation Douglass Sand Depth to top 3746 Bottom 3878 Total Depth of Well 4531 Feet  
Show depth and thickness of all water, oil and gas formations.

OIL, GAS OR WATER RECORDS

CASING RECORD

FORMATION	CONTENT	FROM	TO	SIZE	PUT IN	PULLED OUT
Elgin	Sand	3649	3758	8 5/8	223'	
Hoebner	Silty Sand Shale	3758	3888	5 1/2	4495	2402
Douglas	Sandstone	3888	3945			
Lansing	Buff Limestone	3945	4521			
Mississippi	Chert	4521	4531			

Describe in detail the manner in which the well was plugged, indicating where the mud fluid was placed and the method or methods used in introducing it into the hole. If cement or other plugs were used, state the character of same and depth placed, from \_\_\_\_\_ feet to \_\_\_\_\_ feet for each plug set.

Bridge Plug was set at 3800' in 5 1/2" casing  
Dumped sand and filled up from 3800' to 3725'  
Dumped 5 sacks cement on top sand from 3725 to 3690  
Ripped 5 1/2" casing at 3400, still stuck, ripped pipe at 2402 and pulled.  
Bailed hole down to 224'  
Built wood bridge at 222' added 10' of rock, then dumped 25 sacks cement.  
Loaded hole with mud up to 40' from surface.  
Built 10' rock bridge and dumped 10 sacks cement on top at surface.  
Well plugged and abandoned.

RECEIVED  
STATE CORPORATION COMMISSION

JUL 18 1966  
7-18-66  
CONSERVATION DIVISION  
Wichita, Kansas

(If additional description is necessary, use BACK of this sheet)

Name of Plugging Contractor Clarke Corporation  
Address P.O. Box 187, Medicine Lodge, Kansas

STATE OF New Mexico, COUNTY OF Lea, ss.  
Paul G. White (employee of owner) or (owner or operator) of the above-described well, being first duly sworn on oath, says: That I have knowledge of the facts, statements, and matters herein contained and the log of the above-described well as filed and that the same are true and correct. So help me God.

(Signature) Paul G. White  
P.O. Box 1137, Hobbs, New Mexico (Address)

SUBSCRIBED AND SWORN TO before me this 14th day of July, 19 66

My commission expires August 12, 1969

Mary Sue Williams  
Notary Public.

ORVILLE PARKER  
Chain #1

C SE 1/4 SE 21-31S-11W  
Barl County, Kansas

15-007-00521-0000

Conn: 8-24-54  
Comp: 9-12-54  
Total depth: 4531'

CASING

CEMENT

8 5/8" set @ 223'  
5 1/2" set @ 3911'

140 sacks  
125 sacks on bottom  
& 125 sacks @ 3911'

FORMATION

DEPTH

Clay & sand	0 - 90
Shale & shells	90 - 180
Surface clay	180 - 223
Shale	223 - 995
Shale, salt	995 - 1416
Anhydrite	1416 - 1424
Shale & lime	1424 - 1495
Shale, lime & shells	1495 - 1775
Lime & shale	1775 - 1915
Lime	1915 - 2047
Lime & shale	2047 - 2705
Shale	2705 - 2950
Lime & shale	2950 - 3297
Lime	3297 - 3358
Lime & shale	3358 - 3746
Sand	3746 - 3860
Lime	3860 - 4464
Mississippi lime & chert	4464 - 4476
Cherty lime	4476 - 4499
Lime	4499 - 4531

STATES OF KANSAS )  
                          ) SS  
SEDGWICK COUNTY )

I hereby certify that the above information is true and correct to the best of my knowledge.

*Walter ...*  
\_\_\_\_\_

Subscribed and sworn to before me this 16th day of September, 1954.

*James ...*  
\_\_\_\_\_ Notary Public

My commission expires: June 25, 1956

RECEIVED  
STATE CORPORATION COMMISSION

AUG 5 1966  
8-5-66  
CONSERVATION DIVISION  
Wichita, Kansas