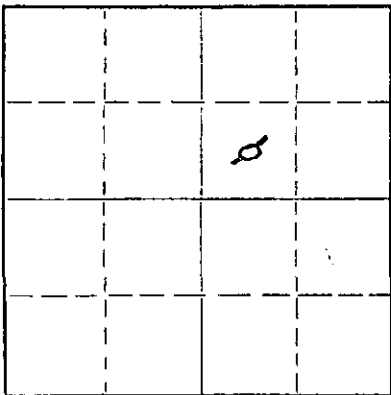


Give All Information Completely
Make Required Affidavit
Mail or Deliver Report to:
Conservation Division
State Corporation Commission
211 No. Broadway
Wichita, Kansas

WELL PLUGGING RECORD

NORTH

Locate well correctly on above
Section Plat

Harper

County. Sec. 30 Twp. 34S Rge. 6W ~~xx~~ (W)

Location as "NE/CNW&SW&" or footage from lines C SW 1/4 NE 1/4

Lease Owner J. M. Huber Corp.

Lease Name Denton-Fox

Well No. 1

Office Address Box 978, Liberal, Kansas

Character of Well (completed as Oil, Gas or Dry Hole) Dry Hole

Date well completed 4-8-56 19

Application for plugging filed 6-12-56 19

Application for plugging approved 6-12-56 19

Plugging commenced 6-13-56 19

Plugging completed 6-13-56 19

Reason for abandonment of well or producing formation Dry Hole

If a producing well is abandoned, date of last production 19

Was permission obtained from the Conservation Division or its agents before plugging was commenced? Yes

Name of Conservation Agent who supervised plugging of this well M. A. Rives

Producing formation Depth to top Bottom Total Depth of Well 5284' Feet

Show depth and thickness of all water, oil and gas formations.

OIL, GAS OR WATER RECORDS

CASING RECORD

FORMATION	CONTENT	FROM	TO	SIZE	PUT IN	PULLED OUT
				8-5/8"	317'	None
				5 1/2"	5232'	3800'

Describe in detail the manner in which the well was plugged, indicating where the mud fluid was placed and the method or methods used in introducing it into the hole. If cement or other plugs were used, state the character of same and depth placed, from feet to feet for each plug set.

Filled with chat to 5205' and dumped 5 sacks cement. Pulled casing to 2000'. Mixed mud and circulated hole with fresh mud. Finished pulling casing. Bridged with rock at 300' with 20 sacks cement dumped on top. Filled hole with mud to 35'. Bridged hole with rock and capped with 10 sacks cement.

RECEIVED
STATE CORPORATION COMMISSION
AUG 9 1956

(If additional description is necessary, use BACK of this sheet)
Name of Plugging Contractor G.M.R. Drilling Co.
Address P.O. Box 1033, Wichita, Kansas

STATE OF KANSAS, COUNTY OF SEWARD, ss.

W. W. Henson

(employee of owner) or ~~owner~~ of the above-described

well, being first duly sworn on oath, says: That I have knowledge of the facts, statements, and matters herein contained and the log of the above-described well as filed and that the same are true and correct. So help me God.

(Signature)

Box 978, Liberal, Kansas

(Address)

SUBSCRIBED AND SWORN TO before me this 8 day of August

1956

My commission expires May 13 1960

Notary Public.

PLUGGING

FILE SEC. 30 T. 34 R. 6W
BOOK PAGE 70 LINE 25

ORIGINAL

PURCHASE ORDER

PRODUCERS OF

CARBON BLACK

GAS AND OIL

PRINTING INKS

KAOLIN CLAY



J. M. HUBER CORPORATION

Drawer 831 Telephone 328

BORGER, TEXAS

No. 115388

PURCHASE ORDER NUMBER
MUST APPEAR ON ALL
INVOICES, PACKAGES AND
CORRESPONDENCE.

Date June 22, 1956

State Corporation Commission
Conservation Division
800 Bitting Bldg.
Wichita, Kansas

SHIP TO: J. M. HUBER CORPORATION

ATTN: Liberal, Kansas

VIA _____

SUBJECT TO TERMS AND CONDITIONS ON THIS AND REVERSE SIDE HEREOF

F.O.B. _____ TERMS _____

Ref. Inv. of 6-18-56

For Plugging Assessment as Follows:

Denton-Fox #1
C SW NE 30-34-6W
Harper County
File No. 70-25 \$25.00

PLUGGING

FILE SEC. 30 T 34 R 6W
BOOK PAGE 70 LINE 25

RECEIVED
STATE CORPORATION COMMISSION

JUN 23 1956
6-23-56
CONSERVATION DIVISION
Wichita, Kansas

IMPORTANT INVOICES MUST BE MAILED
IN QUADRUPLICATE TO BORGER, TEXAS

J. M. HUBER CORPORATION

By J. L. Kyler No. 115388
CLAUD G. BLAIR, Purchasing Agent

CONDITIONS OF PURCHASE

Seller by accepting this order agrees to the following conditions of purchase:

1. Buyer recognizes that Seller may, for operating convenience, desire to utilize its own sales form in acknowledging this order, or otherwise acknowledge it than by simple acceptance. Regardless of the form in which this purchase order may be accepted, Seller agrees that any provisions in the form of acceptance used, which modify, conflict with or contradict any provision of this order, shall be deemed to be waived, and that the provisions of this order constitute the whole contract between the parties.

2. If terms of this order do not appear on or agree with Seller's invoice as rendered Seller agrees that Buyer may change invoice to conform to this order and make payment accordingly.

3. The Seller warrants that goods subject to this order shall conform to specifications, if any, and shall be free from defect in workmanship and material. All such goods shall be subject to inspection and to rejection for breach of warranty by the Buyer within a reasonable time after receipt. The signature of our Receiving Department is for count of original packages only and not for correct weight or count, quality or condition of content. The Seller shall not replace defective goods without the prior written consent of the Buyer.

4. The failure of any goods delivered hereunder to meet the quality herein specified or, except to the extent provided in Paragraph 5 hereof, the failure of the Seller to make any delivery in the quantity or within the time specified or to comply with any of the other terms and conditions hereof shall, at the Buyer's option, relieve Buyer of any obligation to accept such goods or undelivered part thereof and upon any such failure Buyer may place a purchase order elsewhere for an equal or less quantity of goods of the same or substantially equal quality and charge Seller with any loss so incurred. Any failure of Buyer to exercise such option with respect to any portion of this order shall not constitute a waiver with respect to any undelivered installments.

5. In the event of war, fire, flood, accidents, labor troubles, Government act, order or regulation or any other cause or condition beyond the reasonable control of either party hereto, whether similar to the foregoing or not, interfering with production, transportation or use of the goods specified herein, the parties hereto shall be excused from performance hereunder proportionately as Seller's ability to produce or deliver or Buyer's ability to receive or use is reduced by such cause or condition, taking into consideration, however, Seller's stock on hand and its total obligations to make deliveries to Buyer's stock on hand and its total obligations to receive deliveries as the case may be.

6. Seller will give Buyer the benefit of any price declines to actual time of shipment, except that should Buyer permit shipment to be made before specified shipping date, Buyer shall have advantage of lower prices which occur before the specified shipping date.

7. Seller agrees to pack goods covered by this purchase order to comply with I.C.C. regulations and, if for export, to comply with latest Steamship Requirements.

8. Whenever Seller shall, by virtue hereof, have in its possession property of Buyer, Seller shall be deemed an insurer thereof and shall be responsible for its safe delivery to Buyer.

9. Seller certifies that all goods delivered under this contract have been produced in compliance with the Federal Wage and Hour Law (Fair Labor Standards Act of 1938).

10. The within contract or purchase order and these conditions contain the entire agreement between the Buyer and the Seller and there are no prior or contemporaneous, oral or written understandings or agreements binding on the Buyer affecting the subject-matter of the within order other than those expressly referred to therein. No agreement or other understanding in any way modifying the conditions of the contract resulting from the acceptance of the within order will be binding upon the buyer unless made in writing and signed by its authorized representative.

It is requested that Seller show Buyer's purchase order number on acknowledgment, invoices and in all correspondence relative to order. It is also re-

quested that Seller mark each package clearly with Buyer's purchase order number, in all cases where it is practical to do so.

NO. 1 DENTON-FOX

WELL LOG

Location: C. SW/4 NE/4, 30-34S-6W
Harper County, Kansas

Commenced: February 9, 1956

Operator: J. M. Huber Corporation
302 Petroleum Building, Wichita, Ks.

Completed: March 4, 1956

Elevation: 1333 KB (Gr 1323)

Contractor: Graham-Messman-Rinehart Drilling Co.
1005 East Second, Wichita, Kansas

Production:

Casing Record: 8 5/8" @ 317' w/250 sacks cement
5 1/2" @ 5232' w/125 sacks cement

....L O G....

Red Bed-Shale	317
Red Bed	595
Shale	1368
Lime-Shale	2263
Shale-Lime	2970
Lime-Shale	3690
Sandy Shale-Lime	3953
Lime-Kansas City	4094
Lime	4145
Lime-Shale	4514
Shale-Lime	4594
Lime	4680
Yellow Chert	4690
Chert	4718
Lime	4743
Chert	4795
Chert-Lime	4820
Cherty-Lime	4856
Lime-Chert	4910
Cherty Lime	5044
Lime-Shale	5217
Sand	5223 R.T.D.

Sample Tops:

Heebner 330 (-1997)
Stalnaker 3736 (-2403)
Kansas City 4013 (-2680)
Marmaton 4336 (-3003)
Miss. 4672 (-3339)
Viola 5170 (-3837)
Simpson Dol 5200 (-3867)
Simpson Sand 5214 (-3881)

The undersigned, GRAHAM-MESSMAN-RINEHART DRILLING COMPANY, hereby certifies that the above log is a true and correct log of the formation encountered in drilling the above well as reflected by the Daily Drilling Report.

GRAHAM-MESSMAN-RINEHART DRILLING COMPANY

By: _____

J. A. Gilliland

Subscribed and sworn to before me
this 14th day of March 1956.

Jeranita L. Loria
Notary Public

My Commission Expires: November 5, 1958

RECEIVED
NOT COMMISSION
AUG 9 1956

PLUGGING
FILE SEC. 30 T. 34 R. 6W
BOOK PAGE 70 LINE 25