


STATE OF KANSAS
STATE CORPORATION COMMISSION

WELL PLUGGING RECORD

Give All Information Completely
Make Required Affidavit
Mail or Deliver Report to:
Conservation Division
State Corporation Commission
800 Biting Building
Wichita, Kansas

NORTH

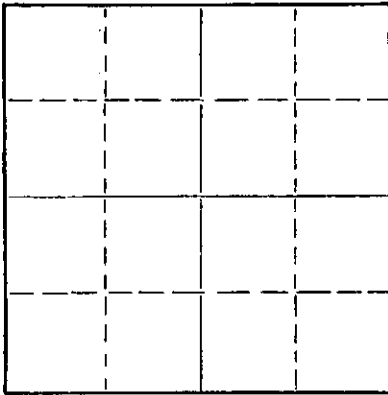

Locate well correctly on above
Section Plat

Harper County, Sec. 35 Twp. 34 Rge. 7 (E) 7 (W)
Location as "NE/CNW/SW" or footage from lines 100' south & 25' east of C NW SW
Lease Owner C. H. Nicholson
Lease Name Sally Carr Well No. 1
Office Address 409 McFarlin Bldg., Tulsa, Oklahoma
Character of Well (completed as Oil, Gas or Dry Hole) Dry hole
Date well completed May 30, 19 55
Application for plugging filed May 30, 19 55
Application for plugging approved May 30, 19 55
Plugging commenced May 30, 19 55
Plugging completed May 30, 19 55
Reason for abandonment of well or producing formation Dry hole

If a producing well is abandoned, date of last production _____ 19____
Was permission obtained from the Conservation Division or its agents before plugging was commenced? Yes

Name of Conservation Agent who supervised plugging of this well Warren H. Horner
Producing formation None Depth to top _____ Bottom _____ Total Depth of Well 5561 Feet
Show depth and thickness of all water, oil and gas formations.

OIL, GAS OR WATER RECORDS

CASING RECORD

FORMATION	CONTENT	FROM	TO	SIZE	PUT IN	PULLED OUT
<u>Wilcox</u>	<u>S Water</u>	<u>5306</u>	<u>5406</u>	<u>8 5/8"</u>	<u>250'</u>	<u>None</u>

Describe in detail the manner in which the well was plugged, indicating where the mud fluid was placed and the method or methods used in introducing it into the hole. If cement or other plugs were used, state the character of same and depth placed, from _____ feet to _____ feet for each plug set.

Hole filled with heavy mud to 245 feet.
Plug set @ 245 feet using 15 sacks of cement and 1/2 sack Hulls
Hole filled to 30 feet with heavy mud.
Plug set using 10 sacks of cement, filled hole to bottom of cellar.

RECEIVED
STATE CORPORATION COMMISSION
8-7-55
CONSERVATION DIVISION
Wichita, Kansas

(If additional description is necessary, use BACK of this sheet)

Name of Plugging Contractor Iron Drilling Co.
Address 1206 Philtower Building, Tulsa, Oklahoma

STATE OF Oklahoma, COUNTY OF Tulsa, ss.
C. H. Nicholson (~~employee of owner~~) (owner or operator) of the above-described well, being first duly sworn on oath, says: That I have knowledge of the facts, statements, and matters herein contained and the log of the above-described well as filed and that the same are true and correct. So help me God.

(Signature) C. H. Nicholson

(Address)

SUBSCRIBED AND SWORN TO before me this 31st day of August, 19 55

Coralie Savage
Notary Public.

My commission expires May 23, 1959

PLUGGING
FILE SEC. 35 T. 34 R. 7W
BOOK PAGE 122 LINE 42

DRILLING RECORD

Well No. 1 Sally Carr
 NW/4 of Sec. 35-34S-7W
 Harper County, Kansas

Casing Record

250' of 8-5/8" OD Surface Pipe
 cemented with 150 sacks.

Well Commenced 4/29/55
 Drilling Commenced 4/30/55
 Drilling Completed 5/29/55
 Well Completed 5/30/55

No Oil String - Dry Hole

WELL LOG

Red Rock & Sand	0 to 300
Red Bed & Shale	300 to 975
Shale	975 to 1273
Anhydrite	1273 to 1282
Shale & Shells	1282 to 1369
Shale & Lime	1369 to 1580
Anhydrite	1580 to 1625
Shale	1625 to 1700
Shale & Shells	1700 to 1795
Shale	1795 to 1950
Lime	1950 to 2055
Lime & Shale	2055 to 2460
Shale	2460 to 2650
Lime	2650 to 2700
Shale & Lime	2700 to 2965
Lime	2965 to 3075
Sandy Lime & Shale	3075 to 3185
Shale & Lime	3185 to 3355
Lime	3355 to 3580
Shale & Lime	3580 to 3655
Lime	3655 to 3690
Shale & Lime	3690 to 3760
Shale	3760 to 3880
Sand	3880 to 3935
Sand & Shale	3935 to 3950
Shale	3950 to 4135
Lime	4135 to 4180
Lime	4180 to 4285
Shale	4285 to 4310
Lime	4310 to 4520
Shale & Lime	4520 to 4580
Lime	4580 to 4630
Lime & Shale	4630 to 4710
Shale & Chert Lime	4710 to 3775
Chert	4775 to 4789
Shale & Cherty Lime	4789 to 4806
Cherty Lime	4806 to 4842
Cherty Lime & Shale	4842 to 4871
Lime	4871 to 4891
Cherty Lime	4891 to 4908
Lime	4908 to 5008
Sandy Lime	5008 to 5032
Cherty Lime	5032 to 5037
Lime	5037 to 5041
Cherty & Sandy Lime	5041 to 5076
Lime	5076 to 5084

Lime & Chert	5084 to 5101
Sandy Lime	5101 to 5111
Lime	5111 to 5113
Sandy Lime	5113 to 5164
Shale & Lime	5164 to 5306
Sand	5306 to 5329
Simpson Sand	5329 to 5334
Shale & Lime	5334 to 5344
Chert & Dolomite	5344 to 5356
Sand	5356 to 5413
Sand & Shale	5413 to 5512
Lime	5512 to 5541
Lime	5541 to 5561

RECEIVED
 OIL CORPORATION COMPANY

PLUGGING
 FILE SEC 25734 R2W
 BOOK PAGE 22 LINE 42

TD