


STATE OF KANSAS
STATE CORPORATION COMMISSION

Form CP-4

WELL PLUGGING RECORD

Give All Information Completely
Make Required Affidavit
Mail or Deliver Report to:
Conservation Division
State Corporation Commission
211 No. Broadway
Wichita, Kansas

Harper County, Sec 23 Twp 34S Rge. (E) 7 (W)
Location as "NE/CNW&SW¼" or footage from lines. Cen. NW/4 NW/4
Lease Owner J.R. Butler
Lease Name Charlie Carr Well No. 1
Office Address 2138 Bank of The Southwest, Houston, Texas - 77002
Character of Well (completed as Oil, Gas or Dry Hole) Dry Hole
Date well completed April 14, 19 67
Application for plugging filed April 14 19 67
Application for plugging approved April 14, 19 67
Plugging commenced April 14, 19 67
Plugging completed April 14, 19 67
Reason for abandonment of well or producing formation Dry Hole

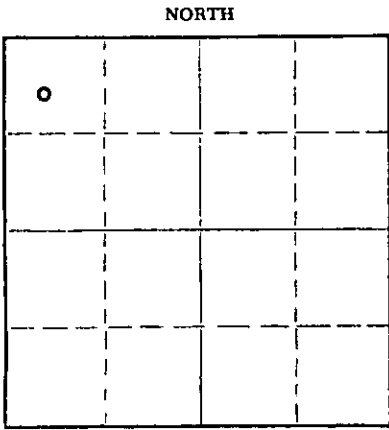

Locate well correctly on above
Section Plat

If a producing well is abandoned, date of last production 19
Was permission obtained from the Conservation Division or its agents before plugging was commenced? Yes

Name of Conservation Agent who supervised plugging of this well Mr. Archie Elving, Box 248, Pratt, Kansas
Producing formation None Depth to top Bottom Total Depth of Well 5,155 Feet
Show depth and thickness of all water, oil and gas formations.

OIL, GAS OR WATER RECORDS

CASING RECORD

FORMATION	CONTENT	FROM	TO	SIZE	PUT IN	PULLED OUT
				8-5/8"-28#	260'	None

Describe in detail the manner in which the well was plugged, indicating where the mud fluid was placed and the method or methods used in introducing it into the hole. If cement or other plugs were used, state the character of same and depth placed, from feet to feet for each plug set.

0' to 40' Howco Plug at base & 15 sack cement plug to surface.
40' to 250' Howco Plug at base & 25 sack cement plug on top w/ cotton seed hulls.
250' to 5155' Circulated hole full of heavy rotary mud.

Plug Bathole w/ rotary mud and 2 sacks cement in top.

Plug Mousehole / rotary mud and 2 sacks cement in top.

RECEIVED
STATE CORPORATION COMMISSION

MAY 1 1967

CONSERVATION DIVISION
WICHITA, KANSAS

(If additional description is necessary, use BACK of this sheet)

Name of Plugging Contractor Corbett Drilling Company
Address P.O. Box 3525 Utica Square, Tulsa, Oklahoma -74152

STATE OF Oklahoma COUNTY OF Tulsa, ss.
L.R. McKinnon (Signature) of owner) or (owner or operator) of the above-described well, being first duly sworn on oath, says: That I have knowledge of the facts, statements, and matters herein contained and the log of the above-described well as filed and that the same are true and correct. So help me God. (Corbett Drilling Co.)

(Signature) L.R. McKinnon
P.O. Box 3525 Utica Square, Tulsa, Oklahoma
(Address)

SUBSCRIBED AND SWORN TO before me this 22 day of April, 19 67

My commission expires August 7, 1969
Notary Public.

J.R. Butler
 2138 Bank of the Southwest Building
 Houston, Texas 77002

Drillers formation log of your Charlie Carr Well No. 1, located in Center of NW/4, NW/4, Section 23, Township 34 South, Range 7 West, Harper County, Kansas.

FROM	TO	FORMATION	
0	262	Surface clay & red beds. Drilled 12 1/4" hole, set 8-5/8" 28# casing @ 260' and cemented with 175 sax reg., 3% c.c. & 2% gel.	
262	1577	Shale and anhydrite.	(Slope test 1 deg. @ 1577')
1577	1725	Lime & Shale.	
1725	1871	Shale, lime & sand. (Sand, 1742-65)	
1871	2927	Shale & lime.	
2927	3052	Shale/w/ sandy lime & lime streaks.	(Slope test 3/4 @ 3052')
3052	3160	Shale & lime.	
3160	3320	Lime, shale & sand.	
3320	3396	Shale & lime.	
3396	3430	Shale, lime & hard sand.	
3430	3805	Shale & lime. (Stalnaker 3796')	
3805	3892	Sand, shale & lime.	(Slope test 3/4 deg. @ 3840')
3892	4025	Shale & lime.	
4025	4065	Kansas City Lime. (Top K.C. 4063')	
4065	4090	Layton sand.	
4090	4319	Shale & lime.	(Slope test 3/4 deg. @ 4259')
4319	4366	Checkerboard lime.	
4366	4544	Marmston (Big Lime/Oswego)	
4544	4570	Cherokee shale.	
4570	4688	Cherokee sand zone.	
4688	4988	Mississippi Lime.	(Slope test 3/4 deg. @ 4740')
4988	5100	Lime & shale.	(Slope test 1/2 deg. @ 5084')
5100	5135	Shale.	
5135	5147	Shale & lime.	
5147	5155	Simpson sand.	
	5155	Total depth. Dry & abandoned. Pumped heavy rotary mud in hole to 250'; set Howco plug & 25 sack cement plug @ 250'; set Howco plug & 15 sack cement plug 40' to surface	

CERTIFICATION

We certify herewith that the above is a true and accurate formation log as transcribed from our daily drilling reports.

CORBETT DRILLING COMPANY

RECEIVED
 STATE CONSERVATION COMMISSION
 MAY 1 1967
 CONSERVATION DIVISION
 Wichita, Kansas

L.R. McKinnon
 L.R. McKinnon Vice President

CORBETT DRILLING COMPANY
 P.O. BOX 3525 - UTICA SQUARE
 TULSA, OKLAHOMA 74152