

15-007-30225-0000

STATE OF KANSAS  
STATE CORPORATION COMMISSION

Give All Information Completely  
Make Required Affidavit  
Mail or Deliver Report to:  
Conservation Division  
State Corporation Commission  
212 No. Market  
Wichita, Kansas

WELL PLUGGING RECORD

Barber County. Sec. 27 Twp. 31 Rge. 11 (E) (W) <sup>λ</sup>

Location as "NE/CNW/SE/SW" or footage from lines \_\_\_\_\_

Lease Owner W. F. Roland Sioyx Petr. Co.

Lease Name Stephenson Well No. #1

Office Address Box 270

Character of Well (completed as Oil, Gas or Dry Hole) Gas

Date well completed December 11, 1965 19 65

Application for plugging filed April 29, 1968 19 68

Application for plugging approved 19 \_\_\_\_\_


Plugging commenced March 7, 1968 19 68

Plugging completed March 25, 1968 19 68

Reason for abandonment of well or producing formation Making too much water, no disposal well

If a producing well is abandoned, date of last production October, 1967

Was permission obtained from the Conservation Division or its agents before plugging was commenced? yes

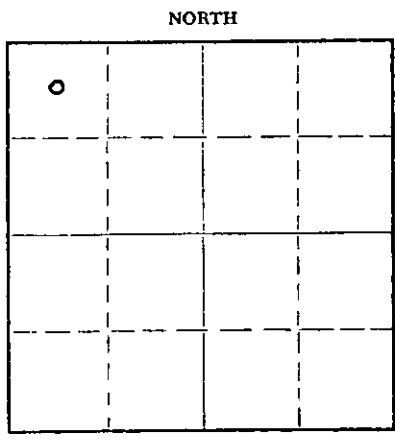

Locate well correctly on above Section Flat

Name of Conservation Agent who supervised plugging of this well Elmo Morgenstern

Producing formation Douglas Depth to top 3756 Bottom \_\_\_\_\_ Total Depth of Well 3756 Feet

Show depth and thickness of all water, oil and gas formations.

OIL, GAS OR WATER RECORDS

CASING RECORD

FORMATION	CONTENT	FROM	TO	SIZE	PUT IN	PULLED OUT
<u>cement</u>				<u>4 1/2</u>		<u>2498 ft.</u>

Describe in detail the manner in which the well was plugged, indicating where the mud fluid was placed and the method or methods used in introducing it into the hole. If cement or other plugs were used, state the character of same and depth placed, from \_\_\_\_\_ feet to \_\_\_\_\_ feet for each plug set.

RECEIVED  
STATE CORPORATION COMMISSION  
APR 30 1968  
CONSERVATION DIVISION  
Wichita, Kansas

(If additional description is necessary, use BACK of this sheet)  
Name of Plugging Contractor Clarke Corporation  
Address Chapin Building, Medicine Lodge, Kansas

STATE OF KANSAS, COUNTY OF BARBER, ss.  
W. F. Roland (employee of owner or (owner/operator) of the above-described well, being first duly sworn on oath, says: That I have knowledge of the facts, statements, and matters herein contained and the log of the above-described well as filed and that the same are true and correct. So help me God.

(Signature) W. F. Roland  
Owner 270 Medicine Lodge Kan.  
(Address)

SUBSCRIBED AND SWORN TO before me this 29 day of April, 1968

Robert C. Gilmore  
Notary Public.

My commission expires \_\_\_\_\_  
**ROBERT C. GILMORE**  
NOTARY PUBLIC  
MY COMM. EXP. APRIL 25, 1971

## DRILLER'S LOG

COMPANY: Sioux Petroleum Company  
 CONTRACTOR: LEBEN DRILLING, INC.  
 FARM: STEPHENSON #1  
 LOCATION: C NW NW Sec. 27-31S-11W  
 BARBER COUNTY, KANSAS  
 COMMENCED: 12-6-65  
 COMPLETED: 12-12-65

0	95	Redbed with Sand
95	210	Redbed
210	800	Redbed, Shale
800	1540	Shale
1540	2310	Lime, Shale
2310	3050	Shale, Lime
3050	3405	Lime, Shale
3405	3550	Shale, Lime
3550	3756	Shale
	<u>3756</u>	<u>RTD - Set 4 1/2" Casing</u>

RECEIVED  
 STATE CORPORATION COMMISSION  
 3-12-68  
 MAR 12 1968  
 CONSERVATION DIVISION  
 Wichita, Kansas

Set 8 5/8" used surface casing @ 209' with 165 sacks 60-40 Posmix  
 Sunset 2% Gel

I, Leslie Kite, do hereby certify that the above and foregoing is a true and correct copy of the log of the Stephenson #1 well, located C NW NW of Section 27, Township 31 South, Range 11 West, Barber County, Kansas, as reflected by the records of Leben Drilling, Inc.

Leslie Kite

Leslie Kite

STATE OF KANSAS )  
 ) SS  
 COUNTY OF BARTON)

Subscribed and sworn to before me, a Notary Public, in and for Barton County, Kansas, this 14th day of December, 1965.

Ulanda Nichols

Ulanda Nichols

My Commission Expires:  
 April 1, 1967