


15-007-0022-00-01

Give All Information Completely
Make Required Affidavit
Mail or Deliver Report to:
Conservation Division
State Corporation Commission
800 Bittig Building
Wichita, Kansas

WELL PLUGGING RECORD

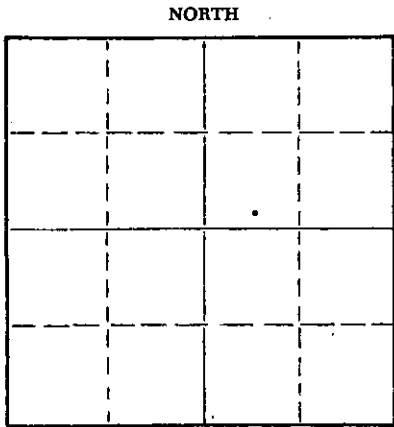

Locate well correctly on above Section Plat

Barber County, Sec. 25 Twp. 31S Rge. 11W (E) (W)

Location as "NE/CNWSW" or footage from lines SE SE SE
Lease Owner Aylward Drilling Company
Lease Name Enderud Well No. 1
Office Address 813 First Nat'l. Bank - Wichita, Kansas
Character of Well (completed as Oil, Gas or Dry Hole) _____
Date well completed _____ 19____
Application for plugging filed _____ 19____
Application for plugging approved _____ 19____
Plugging commenced 4-21-55 19 55
Plugging completed 4-27 19 55
Reason for abandonment of well or producing formation _____

If a producing well is abandoned, date of last production _____ 19____
Was permission obtained from the Conservation Division or its agents before plugging was commenced? Yes

Name of Conservation Agent who supervised plugging of this well Merle Rives
Producing formation _____ Depth to top _____ Bottom _____ Total Depth of Well 4686 Feet
Show depth and thickness of all water, oil and gas formations.

OIL, GAS OR WATER RECORDS

CASING RECORD

FORMATION	CONTENT	FROM	TO	SIZE	PUT IN	PULLED OUT
				8-5/8"	295'	None
				5-1/2"	4686'	4251'

Describe in detail the manner in which the well was plugged, indicating where the mud fluid was placed and the method or methods used in introducing it into the hole. If cement or other plugs were used, state the character of same and depth placed, from _____ feet to _____ feet for each plug set.

Cement inside casing drilled out to 4675' and casing was perforated from 4503' to 4518'. Filled the hole with sand from 4675' to 4495' and ran 5 sacks of cement. Jetted up pits and pumped in 50 barrels of mud at 1500'. Bailed the hole to 295', set a 10' rock bridge and ran 20 sacks of cement. Mudded the hole to 40', set a 10' rock bridge and ran 10 sacks of cement on top. Plugging completed.

(If additional description is necessary, use BACK of this sheet)
Name of Plugging Contractor West Supply Co., Inc.
Address Chase, Kansas

STATE OF Kansas, COUNTY OF Sedgwick, ss.

(employee of owner) or (owner or operator) of the above-described well, being first duly sworn on oath, says: That I have knowledge of the facts, statements, and matters herein contained and the log of the above-described well as filed and that the same are true and correct. So help me God.

(Signature) Paul W Hesse
813 1st Nat'l Bldg - Wichita, Kans.
(Address)

SUBSCRIBED AND SWORN TO before me this 10TH day of MAY, 1955

My commission expires DEC. 11, 1957

Duane Jessup
Notary Public.

PLUGGING
FILE SEC 25 T 31 R 11W
BOOK PAGE 115 LINE 17

5-11-55
CONSERVATION DIVISION
WICHITA, KANSAS

WELL LOG - Enderud #1

OPERATOR: Aylward Drilling Co. et al
813 First National Bank Bldg.,
Wichita, Kansas

LOCATION C SE SE SE
Section 25-31S-11W
Barber County, Kansas

Farm: Enderud Well No. 1

Date Commenced: April, 1955

Date Completed: April 22, 1955

PRODUCTION: D & A

Old hole reopened and tested.

Old Total Depth: 5000 feet - Rotary
5-1/2" set at 4686'

<u>From</u>	<u>To</u>	<u>Formation</u>
0	70	Sand and Gravel
70	150	Red Bed
150	296	Shale & Red Bed - Surface TD
268	296	Plug and Cement
296	500	Red Bed
500	625	Red Bed & Shells
625	1275	Shale & Shells
1275	1480	Shale
1480	1635	Shale & Lime
1635	1660	Lime w/shale strks.
1660	2015	Lime
2015	2075	Lime & Shale
2075	2105	Lime - Hard
2105	2135	Shale - sandy
2135	2178	Lime & Shale brks.
2178	2275	Lime
2275	2320	Lime & Shale
2320	2484	Lime & Shale brks.
2484	2620	Lime & Shale
2620	2745	Shale w/lime strks.
2745	2812	Lime & Shale brks.
2812	2965	Lime & Shale
2965	3298	Lime
3298	3341	Shale
3341	3370	Lime
3370	3470	Lime & Shale
3470	3505	Lime
3505	3520	Shale - Black
3520	3524	Lime
3524	3590	Lime & Shale
3590	3603	Sandy Shale
3603	3629	Lime & Shale - sandy
3629	3824	Lime & Shale
3824	3850	Douglas Sand
3850	4106	Lime
4106	4142	Lime & Shale
4142	4154	Lime
4154	4180	Lime & Shale
4180	4213	Lime
4213	4276	Lime & Shale strks.
4276	4455	Lime
4455	4493	Lime & Shale
4493	4505	Miss. Chat
4505	4520	Chat & Lime
4520	4631	Lime
4631	4640	Shale & Lime strks.
4640	4761	Kinderhook Shale
4761	4786	Shale & Lime strks.
4786	4817	Viola Lime
4817	4852	Lime & Sand
4852	4993	Sand & Shale
4993	5000	Arbuckle Limestone
5000		Total Depth on original hole.
		Total Depth second time 4686' 5-1/2" pipe set at 4686 feet.

