


STATE OF KANSAS
STATE CORPORATION COMMISSION

WELL PLUGGING RECORD

Give All Information Completely
Make Required Affidavit
Mail or Deliver Report to:
Conservation Division
State Corporation Commission
212 No. Market
Wichita, Kansas

BARBER County. Sec. 4 Twp. 30S Rge. (E) 12 (W)
Location as "NE/CNW/SW" or footage from lines C SW SW
Lease Owner FEDERAL PETROLEUM INC.
Lease Name CHANCE Well No. 1
Office Address 1601 LIBERTY BANK BLDG., OKLA. CITY, OKLA.
Character of Well (completed as Oil, Gas or Dry Hole) DRY HOLE
Date well completed MAY 2, 19 68
Application for plugging filed (PHONE 5/2/68) MAY 6, 19 68
Application for plugging approved MAY 2, 19 68
Plugging commenced MAY 2, 19 68
Plugging completed MAY 2, 19 68
Reason for abandonment of well or producing formation _____

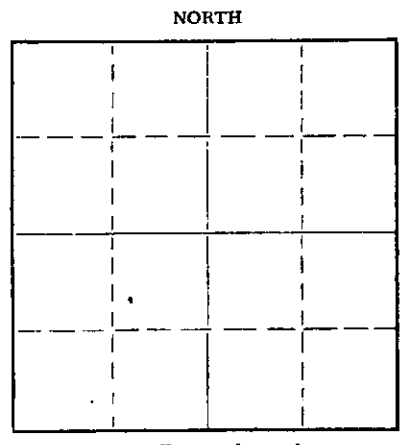

Locate well correctly on above Section Plat

If a producing well is abandoned, date of last production _____ 19____
Was permission obtained from the Conservation Division or its agents before plugging was commenced? YES

Name of Conservation Agent who supervised plugging of this well LEO MASSEY
Producing formation _____ Depth to top _____ Bottom _____ Total Depth of Well 4700 Feet
Show depth and thickness of all water, oil and gas formations.

OIL, GAS OR WATER RECORDS

CASING RECORD

FORMATION	CONTENT	FROM	TO	SIZE	PUT IN	PULLED OUT
		0	371	8-5/8"	371'	NONE

Describe in detail the manner in which the well was plugged, indicating where the mud fluid was placed and the method or methods used in introducing it into the hole. If cement or other plugs were used, state the character of same and depth placed, from _____ feet to _____ feet for each plug set.

FILL HOLE WITH HEAVY MUD TO 360 FEET. SET FIRST PLUG @ 360 FEET WITH 1/2 SACK HULLS AND 25 SACKS CEMENT. FILL HOLE WITH HEAVY MUD TO 40 FEET. SET SECOND PLUG @ 40 FEET WITH 10 SACKS CEMENT. JOB COMPLETE @ 2:00 PM, MAY 2, 1968.

RECEIVED
STATE CORPORATION COMMISSION
MAY 7 1968
CONSERVATION DIVISION
Wichita, Kansas

(If additional description is necessary, use BACK of this sheet)


Name of Plugging Contractor GABBERT-JONES, INC.
Address 830 SUTTON PLACE, WICHITA, KANSAS 67202

STATE OF KANSAS, COUNTY OF SEDGWICK, ss.
E. E. HALL (employee of owner) or (owner or operator) of the above-described well, being first duly sworn on oath, says: That I have knowledge of the facts, statements, and matters herein contained and the log of the above-described well as filed and that the same are true and correct. So help me God.

(Signature) E E Hall

830 SUTTON PLACE, WICHITA, KANSAS
(Address)

SUBSCRIBED AND SWORN to before me this 6TH day of MAY, 19 68

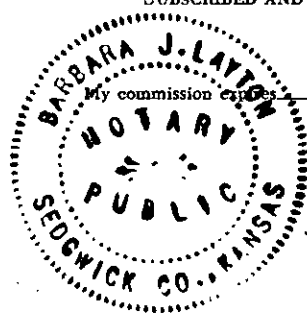

FEBRUARY 1, 1972
Barbara J. Layton
BARBARA J. LAYTON Notary Public.

GABBERT-JONES, INC.
WICHITA, KANSAS
DRILLERS' WELL LOG

CHANCE #1
 C SW SW SECTION 4-30S-12W
 BARBER COUNTY, KANSAS

COMMENCED: APRIL 15, 1968
 COMPLETED: MAY 2, 1968

OPERATOR - FEDERAL PETROLEUM INC.

DEPTH		FORMATION	REMARKS
FROM	To		
0	190	CLAY AND SAND	RAN 20 JOINTS 8-5/8" CASING, SET @ 371' w/275 SACKS CEMENT.
190	371	RED BED AND SHALE	
371	410	RED BED	DRY AND ABANDONED.
410	1540	RED BED AND SHALE	
1540	3908	LIME AND SHALE	
3908	4646	LIME	
4646	4660	SAND	
4660	4700	SAND AND LIME	
4700	TD		

I, E. E. HALL, CERTIFY THIS IS A CORRECT COPY OF THE DRILLERS' LOG FOR THE WELL DRILLED IN THE C SW SW SECTION 4-30S-12W, BARBER COUNTY, KANSAS, TO THE BEST OF MY KNOWLEDGE AND BELIEF.

E. E. Hall

E. E. HALL

STATE OF KANSAS)
) SS
 COUNTY OF SEDGWICK)

BEFORE ME, THE UNDERSIGNED, A NOTARY PUBLIC WITHIN AND FOR SAID COUNTY AND STATE, ON THIS 6TH DAY OF MAY, 1968, PERSONALLY APPEARED E. E. HALL, TO ME PERSONALLY KNOWN TO BE THE IDENTICAL PERSON WHO EXECUTED THE WITHIN AND FOREGOING INSTRUMENT AND ACKNOWLEDGED TO ME THAT HE EXECUTED THE SAME AS HIS FREE AND VOLUNTARY ACT AND DEED FOR THE USES AND PURPOSES THEREIN SET FORTH.

IN WITNESS WHEREOF, I HAVE HEREUNTO SET MY HAND AND OFFICIAL SEAL THE DAY AND YEAR LAST ABOVE WRITTEN.

Barbara J. Layton
 BARBARA J. LAYTON, NOTARY PUBLIC

My Commission Expires February 1, 1972.

