

STATE OF KANSAS  
STATE CORPORATION COMMISSION

Give All Information Completely  
Make Required Affidavit  
Mail or Deliver Report to:  
Conservation Division  
State Corporation Commission  
11 No. Broadway  
Wichita, Kansas

WELL PLUGGING RECORD

Barber County, Sec. 1 Twp. 30 S. Rge. (E) 12 (W)

Location as "NE/CNW&SW&" or footage from lines Ctr. NE SE

Lease Owner Grayhol Oil Corporation

Lease Name Coss Well No.

Office Address 2200 National Bank of Tulsa Bldg., Tulsa, 3, Oklahoma

Character of Well (completed as Oil, Gas or Dry Hole)

Date well completed September 26 19 63

Application for plugging filed September 27 19 63

Application for plugging approved September 28 19 63


Plugging commenced September 28 19 63

Plugging completed September 28 19 63

Reason for abandonment of well or producing formation Dry hole.

If a producing well is abandoned, date of last production 19

Was permission obtained from the Conservation Division or its agents before plugging was commenced? Yes

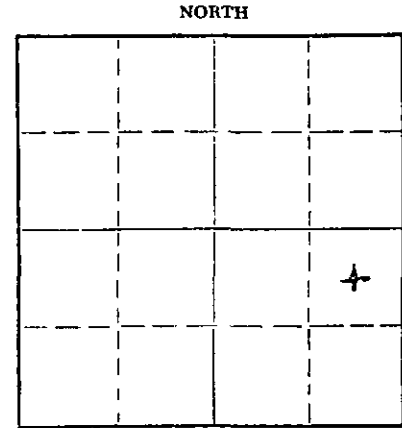

Locate well correctly on above Section Plat

Name of Conservation Agent who supervised plugging of this well Archie V. Elving

Producing formation None Depth to top Bottom Total Depth of Well 4813 Feet

Show depth and thickness of all water, oil and gas formations.

OIL, GAS OR WATER RECORDS

CASING RECORD

FORMATION	CONTENT	FROM	TO	SIZE	PUT IN	PULLED OUT
Lansing Lime	Water	3882	4298	8 5/8"	267	None
Mississippian Lime	Tight	4360	4422			
Viola Lime	Tight	4575	4653			
Simpson Sand	Water	4655	4714			
Arbuckle Lime	Water	4769	4813			

Describe in detail the manner in which the well was plugged, indicating where the mud fluid was placed and the method or methods used in introducing it into the hole. If cement or other plugs were used, state the character of same and depth placed, from feet to feet for each plug set.

Filled hole with heavy mud-laden fluid to 260', placed 20 sacks of Portland cement in hole. Filled hole with heavy mud-laden fluid to 40'. Cemented hole with ten sacks of Portland cement from 40' to surface. Put two sacks of Portland cement in rathole.

RECEIVED  
STATE CORPORATION COMMISSION

OCT 2 1963

CONSERVATION DIVISION  
Wichita, Kansas

(If additional description is necessary, use BACK of this sheet)

Name of Plugging Contractor None used.

Address

STATE OF Oklahoma, COUNTY OF Tulsa, ss.

Lyman C. Dennis (employee of owner) or (owner or operator) of the above-described well, being first duly sworn on oath, says: That I have knowledge of the facts, statements, and matters herein contained and the log of the above-described well as filed and that the same are true and correct. So help me God.

(Signature) Lyman C. Dennis

Tulsa, Oklahoma (Address)

SUBSCRIBED AND SWORN TO before me this 1st day of October, 19 63

Jan Carrigan Notary Public.

My commission expires Oct 8, 1966



GRAYBOL OIL CORPORATION

Barber County, Kansas

No. 1 Coss

Ctr. NE SE Section 1-30-12W

Contractor: Company Tools

Elev: 1836' D.F. 1830' G.L.

Commenced: September 7, 1963

Completed: September 26, 1963

Production: Dry & Abandoned

CASING RECORD

Set 8 5/8" Casing at 267' with 165 sacks of pozmix cement.

<u>DEPTH</u>	<u>FORMATION</u>	<u>WELEX ELECTRIC LOG TOPS:</u>	
0-235	Surface Clay and Sand	Tarkio lime	2932
235-270	Shale	Emporia lime	2986
270-305	Red Bed and Shale	Howard lime	3164
305-735	Shale	Topeka lime	3312
735-850	Red bed, gyp and Anhydrite	Heebner shale	3697
850-1912	Shale and shells	Toronto lime	3719
1912-1920	Lime	Douglas sand	3758
1920-2170	Lime and shale	Brown lime	3873
2170-2280	Lime	Lansing lime	3882
2280-2955	Lime and shale	Base of Kansas City	4298
2955-3040	Lime	Mississippian Chert	4360
3040-3435	Lime and shale	Kinderhook shale	4422
3435-3567	Lime	Viola lime	4575
3567-3760	Lime and shale	Simpson shale	4653
3760-3794	Sandy lime	Simpson sand	4656
3794-3917	Lime and shale	Arbuckle dolomite	4769
3917-4312	Lime	Welex Total Depth	4815
4312-4356	Lime and shale		
4356-4395	Lime, cherty		
4395-4427	Lime and shale		
4427-4443	Lime		
4443-4499	Shale and lime		
4499-4535	Lime and shale		
4535-4588	Shale and lime		
4588-4613	Lime		
4613-4633	Cherty lime		
4633-4662	Lime and chert		
4662-4686	Sand		
4686-4696	Sand and shale		
4696-4708	Lime and sand		
4708-4762	Sand and shale		
4762-4813	Lime		
4813	Driller's Total Depth		

**RECEIVED**  
 STATE CORPORATION COMMISSION  
 OCT 2 1963  
 CONSERVATION DIVISION  
 Wichita, Kansas

I hereby certify that the above is a true and correct log of the above-captioned well as taken directly from the daily drilling reports.

GRAYBOL OIL CORPORATION

By: Lyman C. Dennis  
Lyman C. Dennis, Geologist

STATE OF OKLAHOMA

COUNTY OF TULSA

Subscribed and sworn to this 1<sup>st</sup> day of October, 1963

My Commission expires: October 8, 1966

Jan Carrigan  
NOTARY PUBLIC