


WELL PLUGGING RECORD

Give All Information Completely
Make Required Affidavit
Mail or Deliver Report to:
Conservation Division
State Corporation Commission
211 No. Broadway
Wichita, Kansas

Barber County. Sec. 29 Twp. 31 Rge. 11 (W)
Location as "NE/CNW/SW" or footage from lines SE SE SE
Lease Owner Lario Oil & Gas Co.
Lease Name Whelan "B" Well No. 1
Office Address 301 S. Market, Wichita, Kansas
Character of Well (Oil, Gas or Dry Hole) Dry Hole
Date well completed April 9, 19 57
Application for plugging filed April 9, 19 57
Application for plugging approved April 9, 19 57
Plugging commenced April 9, 19 57
Plugging completed April 9, 19 57
Reason for abandonment of well or producing formation Dry Hole

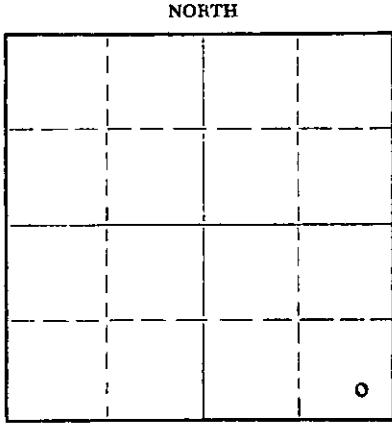

Locate well correctly on above
Section Plat

If a producing well is abandoned, date of last production 19
Was permission obtained from the Conservation Division or its agents before plugging was commenced? Yes

Name of Conservation Agent who supervised plugging of this well Merle Rives
Producing formation _____ Depth to top _____ Bottom _____ Total Depth of Well 4460 Feet
Show depth and thickness of all water, oil and gas formations.

OIL, GAS OR WATER RECORDS

CASING RECORD

FORMATION	CONTENT	FROM	TO	SIZE	PUT IN	PULLED OUT
				8 5/8"	233	None - Cem. to top.

Describe in detail the manner in which the well was plugged, indicating where the mud fluid was placed and the method or methods used in introducing it into the hole. If cement or other plugs were used, state the character of same and depth placed, from _____ feet to _____ feet for each plug set.

Filled hole with heavy mud to 225'. Plug at 225' with 20 sack cement.
Mud to 35'. Plug at 35' with 10 sacks cement to top of hole.

(If additional description is necessary, use BACK of this sheet)

Name of Plugging Contractor Group Exploration Company
Address Sterling, Kansas

STATE OF Kansas, COUNTY OF Sedgwick, ss.
Leo Ross (employee of owner) or (owner or operator) of the above-described well, being first duly sworn on oath, says: That I have knowledge of the facts, statements, and matters herein contained and the log of the above-described well as filed and that the same are true and correct. So help me God.

(Signature) [Signature]
301 South Market, Wichita 2, Kansas
(Address)

SUBSCRIBED AND SWORN TO before me this 16th day of April, 19 57

My commission expires July 21, 1958

[Signature] Notary Public.
STATE CORPORATION COMMISSION

PLUGGING
FILE SEC. 29 T. 31 R. 11W
BOOK PAGE 5 LINE 26

APR 17 1957
4-17-57
CONSERVATION DIVISION
Wichita, Kansas

LARIO OIL & GAS CO.
 Joe Whelan "B" No. 1
 SE SE SE Sec. 29-31S-11W
 Barber County, Kansas

Drilling Commenced: March 20, 1957
 Drilling Completed: April 9, 1957
 Drilling Contractor: Group Exploration Company, Sterling, Kansas
 Total Depth - 4460'

Plugged and Abandoned

<u>Formation</u>	<u>Depth</u>	<u>Casing Record:</u>
Rock & red bed	230	8 5/8" 233' Set @ 227'
Red bed and shale	700	Cem. w/ 200 sacks
Shale & lime	1585	
Lime & shale	1875	
Lime	2190	
Lime & shale	2250	
Lime	2480	
Shale & lime	2560	
Shale	2745	
Shale & lime	2910	
Lime	3100	
Shale & lime	3335	
Shale	3430	
Shale & lime	3505	
Sand & shale	3570	
Shale & sand	3624	
Sand	3632	
Sand & shale	3685	
Shale & lime	3777	
Lime	4368	
Mississippi Chert	4421	
Chert & shale	4455	
Limestone & chert	4460	

GEOLOGICAL TOPS (Sample) - K.B. Meas.	
Topeka	2813 (-1215)
Elgin Section	3445 (-1847)
Heebner	3596 (-1998)
Douglas Section	3604 (-2006)
Douglas Sand	3616 (-2018)
Base Sand	3676 (-2078)
Lansing-K.C.	3776 (-2178)
Cherokee Section	4345 (-2747)
Mississippi	4350 (-2752)
Mississippi Chat	4358 (-2760)
Base Chat	4398 (-2800)
Fresh Chert	4398 (-2800)
Base Chert	4433 (-2835)
Rotary T.D.	4460 (-2862)
Schlumberger T.D.	4456 (-2858)

STATE CORPORATION
 APR 17 1957
 CONSERVATION 4-17-57

PLUGGING
 FILE SEC. 29 T. 31 R. 11W
 BOOK PAGE 5 LINE 26