


15-007-10034-0000

STATE OF KANSAS
STATE CORPORATION COMMISSION

WELL PLUGGING RECORD

Give All Information Completely
Make Required Affidavit
Mail or Deliver Report to:
Conservation Division
State Corporation Commission
211 No. Broadway
Wichita, Kansas

NORTH

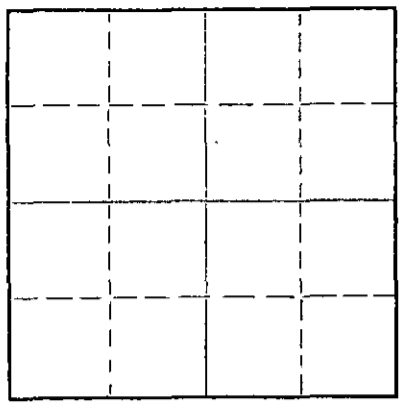

Locate well correctly on above
Section Plat

Barber County, Sec. 29 Twp. 31 Rge. 11 (E) W (W)
Location as "NE/CNW/SW" or footage from lines NE-SW-NW
Lease Owner J. A. Aylward
Lease Name Wheilan Well No. 2
Office Address Wichita, Kansas
Character of Well (completed as Oil, Gas or Dry Hole) Oil
Date well completed March 6 19 52
Application for plugging filed June 23 19 57
Application for plugging approved June 25 19 57
Plugging commenced 6-27-57 19
Plugging completed 7-3-57 19
Reason for abandonment of well or producing formation Dry

If a producing well is abandoned, date of last production May 19 57
Was permission obtained from the Conservation Division or its agents before plugging was commenced? yes

Name of Conservation Agent who supervised plugging of this well Merle Rives
Producing formation _____ Depth to top _____ Bottom _____ Total Depth of Well 4405 Feet
Show depth and thickness of all water, oil and gas formations.

OIL, GAS OR WATER RECORDS

CASING RECORD

FORMATION	CONTENT	FRDM	TO	SIZE	PUT IN	PULLED OUT
				8-5/8	200'	none
				5 1/2	4355'	3873'

Describe in detail the manner in which the well was plugged, indicating where the mud fluid was placed and the method or methods used in introducing it into the hole. If cement or other plugs were used, state the character of same and depth placed, from _____ feet to _____ feet for each plug set.

Checked hole to ~~4405~~ 4405', found open.
Filled w/sand to 4345' and ran 5 sacks of cement. Pulled casing, baled hole and mudded to 210', set a 10' rock bridge and ran 20 sacks of cement. Mudded hole to 40', set a rock bridge and ran 10 sacks of cement to base of cellar.
Plugging completed.

(If additional description is necessary, use BACK of this sheet)

Name of Plugging Contractor West Supply Co., Inc.
Address Chase, Kansas

STATE OF KANSAS, COUNTY OF RICE, ss.
Paul W. Hesse (employee of owner) or (owner or operator) of the above-described well, being first duly sworn on oath, says: That I have knowledge of the facts, statements, and matters herein contained and the log of the above-described well as filed and that the same are true and correct. So help me God.

(Signature) Paul W. Hesse
813 1st Natl. Bank Bldg., Wichita, Kansas
(Address)

SUBSCRIBED AND SWORN TO before me this 5th day of July, 19 57

My commission expires 9-27-58
Thomas V. Doyne Notary Public.

PLUGGING
FILE SEC 29 T. 31 R. 11
BOOK PAGE 23 LINE 13

RECEIVED
STATE CORPORATION COMMISSION
JUL 24 1957
7-24-57
CONSERVATION DIVISION
Wichita, Kansas

WHELAN #2

Casing Record:

8 5/8" - 120'
5 1/2" - 4353'Company: J. A. Aylward
Contractor: Aylward Drilling CompanyCommenced: February 17, 1952
Completed: March 6, 1952Location: NE SW NW 29-31-11W
Barber County
Kansas

Elevation: 1608 K.B.

	<u>From</u>	<u>To</u>	<u>Remarks</u>
Surface Sand & Clay	0	120	Set 8 5/8" surf. pipe @ 120' w/60 sacks cement.
Red Bed	120	160	
Shale, shells & Red Bed	160	630	GEOLOGICAL TOPS:
Shale & Shells	630	1310	
Shells & Shale	1310	1399	Lansing/Kansas City 1003781
Lime	1399	1400	Mississippian (Chat) 4351
Shale & Shells	1400	1580	R.T.D. 4355
Lime & Shells	1580	1750	
Lime & Shale	1750	1905	
Lime	1905	2105	
Broken Lime	2105	2205	
Broken Lime & Shale	2205	2280	
Lime	2280	2340	
Shale & Lime	2340	2780	
Lime & Shale	2780	2965	
Lime	2965	3025	
Shale & Lime	3025	3160	
Lime, broken	3160	3230	
Lime	3230	3280	
Lime, broken	3280	3365	
Shale & Lime	3365	3455	
Sand, Shale & Shells	3455	3480	
Shale & Lime	3480	3515	
Lime & Shale	3515	3650	
Shale & Lime	3650	3730	
Lime	3730	4245	Set 5 1/2" casing @ 4353' w/50 sacks cement.
Shale & Lime	4245	4290	
Lime & Shale	4290	4351	
Miss. Chat	4351	4355 T.D.	

I hereby certify that this is a true and correct copy of the above log to the best of my knowledge.

Paul W. Hesse

Subscribed and sworn to before me this 23rd day of July, 1957.

Duane Jessup
DUANE JESSUP Notary Public

My commission expires December 11, 1957

RECEIVED
STATE CORPORATION COMMISSION

JUL 24 1957
7-24-57
CONSERVATION DIVISION
Wichita, Kansas

PLUGGING	
FILE SEC	29 T. 31 R. 11W
BOOK PAGE	23 LINE 13