


STATE OF KANSAS  
STATE CORPORATION COMMISSION

WELL PLUGGING RECORD

Give All Information Completely  
Make Required Affidavit  
Mail or Deliver Report to  
Conservation Division  
State Corporation Comm.  
245 North Water  
Wichita, KS 67202

Barber County. Sec. 29 Twp. 31S Rge. 11 E/W  
Location as "NE/CNW 1/4 SW 1/4" or footage from lines  
SW SW SE  
Lease Owner Falcon Exploration, Inc.  
Lease Name Whelan Well No. 1  
Office Address Suite 1531, KSB&T Building, Wichita, Kansas 67202  
Character of Well (Completed as Oil, Gas or Dry Hole)

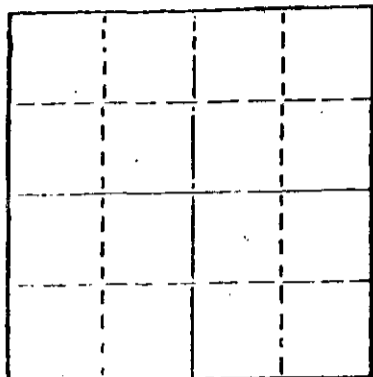

Locate well correctly on above Section Plat

Dry Hole  
Date Well completed July 23, 19 81  
Application for plugging filed July 23, 19 81  
Application for plugging approved July 23, 19 81  
Plugging commenced July 23, 19 81  
Plugging completed July 23, 19 81  
Reason for abandonment of well or producing formation

If a producing well is abandoned, date of last production 19

Was permission obtained from the Conservation Division or its agents before plugging was commenced? Yes

Name of Conservation Agent who supervised plugging of this well Carl Barnett, Winfield, Kansas  
Producing formation Depth to top Bottom Total Depth of Well 4431'  
Show depth and thickness of all water, oil and gas formations.

OIL, GAS OR WATER RECORDS

CASING RECORD

FORMATION	CONTENT	FROM	TO	SIZE	PUT IN	PULLED OUT
				8-5/8"	252'	None

Describe in detail the manner in which the well was plugged, indicating where the mud fluid was placed and the method or methods used in introducing it into the hold. If cement or other plugs were used, state the character of same and depth placed, from feet to feet for each plug set.

Pumped 35 sacks cement through drill pipe to 265'. Pushed plug & hulls to 40 feet with 10 sacks cement. Plugged rat hole with 5 sacks cement.

RECEIVED  
STATE CORPORATION COMMISSION  
JUL 31 1981  
7-31-81  
CONSERVATION DIVISION  
Wichita, Kansas  
ss.

(If additional description is necessary, use BACK of this sheet)

Name of Plugging Contractor Graves Drilling Co., Inc.

STATE OF KANSAS COUNTY OF SEDGWICK

Betty Brandt (employee of owner) or (owner or operator)

of the above-described well, being first duly sworn on oath, says: That I have knowledge of the facts, statements, and matters herein contained and the log of the above-described well as filed and that the same are true and correct. So help me God.

(Signature)

*Betty Brandt*

910 Union Center, Wichita, Kansas 67202  
(Address)

SUBSCRIBED AND SWORN TO before me this 30th day of July, 1981

My commission expires May 17, 1983


*Rebecca L. Matthews*  
Rebecca L. Matthews Notary Public.

R O T A R Y D R I L L E R S ' L O G

OPERATOR: Falcon Exploration, Inc. DRILLING COMMENCED: July 16, 1981  
 Suite 1531, KSB&T Building  
 Wichita, Kansas 67202

CONTRACTOR: Graves Drilling Co., Inc. DRILLING COMPLETED: July 23, 1981  
 910 Union Center  
 Wichita, Kansas 67202

CASING RECORD: 6 Jts. 252' of new 8-5/8" LOCATION: Whelan No. 1  
 cemented with 185 sacks. SW SW SE  
 Section 29-31S-11W  
 Barber County, Kansas

 

0 - 1220 Red bed  
 1220 - 1762 Shale  
 1762 - 4431 Shale & lime  
 4431 Rotary Total Depth

I hereby certify the foregoing statements to be true and correct to the best of my knowledge.

Copy sent to:  
 State Corporation Commission  
 Kansas Geological Society  
 Kansas Geological Survey

GRAVES DRILLING CO., INC.  
 By *Leif H. ...*  
 Secretary-Treasurer

STATE OF KANSAS )  
 ) ss.  
 SEDGWICK COUNTY )

Subscribed and sworn to before me, a Notary Public, this 30th day of July, 1981.

RECEIVED  
 STATE CORPORATION COMMISSION  
 JUL 31 1981  
 7-31-81  
 CONSERVATION DIVISION  
 Wichita, Kansas  
*Rebecca L. Matthews*  
 Rebecca L. Matthews Notary Public

My commission expires:  
 May 17, 1983