

15-007-00372-0000


STATE OF KANSAS
STATE CORPORATION COMMISSION

WELL PLUGGING RECORD

Give All Information Completely
Make Required Affidavit
Mail or Deliver Report to:
Conservation Division
State Corporation Commission
800 Bitting Building
Wichita, Kansas

Barber County, Sec. 29 Twp. 31S Rge. 11 W (W)

Location as "NE/CNW $\frac{1}{4}$ SW $\frac{1}{4}$ " or footage from lines SW SW NE
Lease Owner Globe Oil & Refining Co.
Lease Name Whelan "C" Well No. 1
Office Address 301 South Market, Wichita 2, Kansas
Character of Well (completed as Oil, Gas or Dry Hole) Dry Hole
Date well completed June 14, 19 53
Application for plugging filed (written) June 18, 19 53
Application for plugging approved (written) June 17, 19 53
Plugging commenced June 15, 19 53
Plugging completed June 15, 19 53
Reason for abandonment of well or producing formation Dry Hole

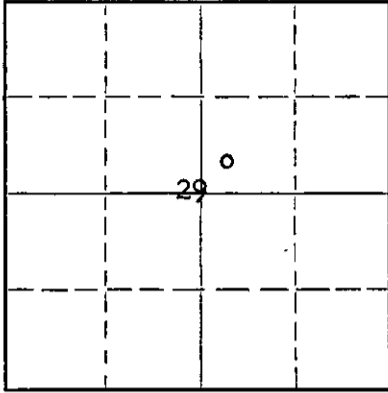

Locate well correctly on above
Section Plat

If a producing well is abandoned, date of last production 19
Was permission obtained from the Conservation Division or its agents before plugging was commenced? Yes

Name of Conservation Agent who supervised plugging of this well M. A. Rives, Box 148, Pratt, Kansas
Producing formation Depth to top Bottom Total Depth of Well 4472 Feet
Show depth and thickness of all water, oil and gas formations.

OIL, GAS OR WATER RECORDS

CASING RECORD

Formation	Content	From	To	Size	Put In	Pulled Out
Mississippi Chat	Show Oil	4357	4435	8 5/8"	126'	None

Describe in detail the manner in which the well was plugged, indicating where the mud fluid was placed and the method or methods used in introducing it into the hole. If cement or other plugs were used, state the character of same and depth placed, from feet to feet for each plug set.

Plugged as follows by orders of M. A. Rives, State Plugger:
Set bridge at 250' and cemented with 45 sacks of cement down the drill pipe.
Set bridge at 40' and cemented with 10 sacks down the surface pipe.
(Cement was all mixed well in cement mixer).

STATE CORP. COM. DIVISION
6-19-53
Wichita, Kansas

Name of Plugging Contractor Aylward Drilling Company
Address Wichita, Kansas

STATE OF KANSAS, COUNTY OF SEDGWICK, ss.
Leo Ross (employee of owner) or (owner or operator) of the above-described well,

being first duly sworn on oath, says: That I have knowledge of the facts, statements, and matters herein contained and the log of the above-described well as filed and that the same are true and correct. So help me God.

(Signature) Leo Ross
301 South Market, Wichita, Kansas
(Address)

SUBSCRIBED AND SWORN to before me this 18th day of June, 19 53
Frances Sealie
Notary Public.

My commission expires July 21, 1954 23-8390-s 6-51-20M

PLUGGING
FILE SEC 29 T 31 R 11W
PAGE 108 LINE 25

GLOBE OIL & REFINING CO.
 Whelan "C" No. 1
 SW SW NE Sec. 29-31S-11W
 Barber County, Kansas

Drilling Commenced: 5-23-53
 Drilling Completed: 6-14-53
 Drilling Contractor: Aylward Drilling Co.
 Total Depth: 4472'
 Dry & Abandoned

Casing Record:

8 5/8" 126' set @ 134'

<u>Formation</u>	<u>Depth:</u>	<u>Geological Tops</u>	
Red bed & shale	1025	Topeka	2831
Shale	1305	Elgin Zone	3437
Shale & shells	1725	Elgin Sand	3485
Lime & shale	2045	Base Oread	3620
Lime	2132	Douglas Sand	3620
Lime & shale	2594	Lansing	3791
Shale & shells	2705	Mississippi Chat	4357
Lime & shale	2975	Limy Shale Zone	4435
Lime	3075	Rotary T.D.	4472
Shale & lime	3305		
Shale & shells	3370	D. & A.	
Shale & lime	3452		
Shale	3486		
Sand	3496		
Sandy shale & lime	3603		
Shale & shells	3625		
Sand	3660		
Lime & shale	3720		
Sand & shale	3758		
Sandy shale & lime	3800		
Lime & shale	3854		
Lime	3882		
Shale	3892		
Lime	4189		
Lime & shale	4271		
Shale & lime shells	4305		
Lime & shale	4355		
Chat	4407		
Chat & shale	4417		
Lime	4437		
Lime & shale	4462		
Shale	4472 T.D.		

PLUGGING
 FILE SEC. 29 T. 31 R. 11W
 BOOK PAGE 108 LINE 25

RECEIVED
 STATE CORPORATION COMMISSION
 6-19-53
 STATE OF KANSAS