

Give All Information Completely  
Make Required Affidavit  
Mail or Deliver Report to:  
Conservation Division  
State Corporation Commission  
211 No. Broadway  
Wichita, Kansas

WELL PLUGGING RECORD

Barber County, Sec. 35 Twp. 34S Rge. 13 (E) W

Location as "NE/CNW/SW" or footage from lines Center SW/4 NE/4

Lease Owner Bachus Oil Company

Lease Name Edd Sterling Well No. 3(Three)

Office Address 721 East Central, Wichita, Kansas

Character of Well (completed as Oil, Gas or Dry Hole) Dry Hole

Date well completed 10-8 19 58

Application for plugging filed 10-8 19 58

Application for plugging approved 10-8 19 58

Plugging commenced 10-8 19 58

Plugging completed 10-8 19 58

Reason for abandonment of well or producing formation production not in commercial quantities

If a producing well is abandoned, date of last production - - - - - 19

Was permission obtained from the Conservation Division or its agents before plugging was commenced? Yes

Name of Conservation Agent who supervised plugging of this well Mr. W. L. Lackamp

Producing formation Miss Depth to top Bottom Total Depth of Well 4880 Feet

Show depth and thickness of all water, oil and gas formations.

OIL, GAS OR WATER RECORDS

CASING RECORD

FORMATION	CONTENT	FROM	TO	SIZE	PUT IN	PULLED OUT

Describe in detail the manner in which the well was plugged, indicating where the mud fluid was placed and the method or methods used in introducing it into the hole. If cement or other plugs were used, state the character of same and depth placed, from \_\_\_\_\_ feet to \_\_\_\_\_ feet for each plug set.

Well was filled with heavy mud from 4880' to 220'  
wood plug @ 220'. Globe Oil Well Cementing pumped  
50 sacks of cement on top plug. Cement filled Surface Pipe  
to top of hole.

RECEIVED  
STAT. CORPORATION COMMISSION

OCT 30 1958

CONSERVATION DIVISION  
Wichita, Kansas

(If additional description is necessary, use BACK of this sheet)

Name of Plugging Contractor BACHUS OIL COMPANY  
Address 721 EAST CENTRAL, WICHITA, KANSAS

STATE OF KANSAS COUNTY OF SEDGWICK, ss.  
Wm. A. Cecil, Gen. Mgr. (employee of owner) or (owner or operator) of the above-described

well, being first duly sworn on oath, says: That I have knowledge of the facts, statements, and matters herein contained and the log of the above-described well as filed and that the same are true and correct. So help me God.


(Signature) W.A. Cecil  
Wm. A. Cecil, Gen. Mgr.  
721 East Central, Wichita, Kansas  
(Address)

SUBSCRIBED AND SWORN TO before me this 29th day of October, 19 58

Gail L. Thyfault  
Gail L. Thyfault Notary Public.

My commission expires 10-19-60

PLUGGING  
FILE SEC 35 T. 34 R. 13W  
BOOK PAGE 136 LINE 2

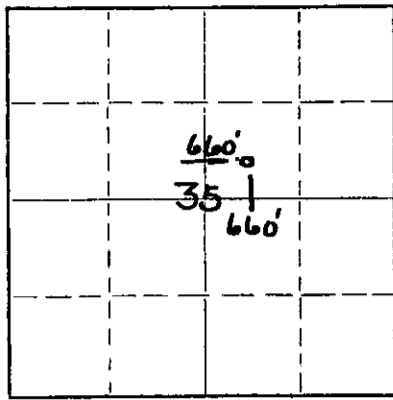

Locate well correctly on above Section Plat

DRILLING LOG

COMPANY: Bachus Oil Company  
721 East Central  
Wichita, Kansas

LEASE: EDD STERLING

WELL: #3

LOCATION: Center SW/4 NE/4 of Section 35-34S-13W  
Barber County, Kansas

DATE COMM: 9-23-58

DATE COMP: 10-8-58

T.D. 4880'

CASING: Surface casing 8 5/8" set @ 282' w/225 sacks common cement.

Figures Indicate the Bottom of Formation

0-283	Red Rock, Sand & Red Bed
440	Red Bed, Gyp and Shells
800	Red Bed
1445	Shale and Shells
1470	Anhydrite
1715	Shale and Lime
2080	Lime
2115	Lime and Shale
2140	Lime
2180	Lime and Shale
2300	Shale and Lime
2410	Lime and Shale
3083	Shale and Lime
3245	Lime and Shale
3370	Shale and Lime
3555	Lime and Shale
3585	Shale and Lime
3760	Sandy Shale, Sand Lime
3863	Lime and Shale
3885	Shale and Lime
4025	Lime and Shale
4080	Sandy Shale
4125	Lime, Kansas City
4539	Lime Chert
4667	Lime
4735	Shale and Lime
4760	Lime and Shale
4779	Cherokee Sand
4789	Sand
4793	Lime and Chert
4795	Mississippi
4855	Mississippi Lime and Chert
4880	Mississippi

I certify the above to be true and correct to the best of my knowledge and belief.

BACHUS OIL COMPANY

BY Wm. A. Cecil, Gen. Mgr.

Subscribed and sworn before me this 10<sup>th</sup> day of Oct., 1958.

My Commission Expires 10-19-60

Gail L. Thyfault  
Gail L. Thyfault, Notary Public

PLUGGING

FILE SEC 35 T 34 R 13W  
BOOK PAGE 136 LINE 2