


STATE OF KANSAS
STATE CORPORATION COMMISSION

WELL PLUGGING RECORD

Give All Information Completely
Make Required Affidavit
Mail or Deliver Report to:
Conservation Division
State Corporation Commission
211 No. Broadway
Wichita, Kansas

NORTH

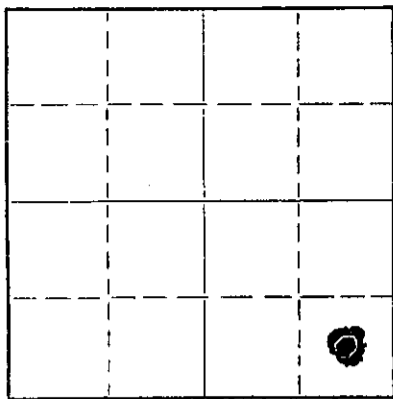

Locate well correctly on above
Section Plat

Barber County. Sec. 35 Twp. 34 Rge. 13 (E) W (W)
Location as "NE/CNW/SW" or footage from lines Center SE/4 SE/4
Lease Owner Bachus Oil Company
Lease Name Good "A" Well No. #1
Office Address 721 East Central, Wichita, Kansas
Character of Well (completed as Oil, Gas or Dry Hole) Dry Hole
Date well completed 11-9 19 58
Application for plugging filed 11-9 19 58
Application for plugging approved 11-9 19 58
Plugging commenced 11-9 19 58
Plugging completed 11-9 19 58
Reason for abandonment of well or producing formation no production in commercial quantities.
If a producing well is abandoned, date of last production --- --- --- 19 ---
Was permission obtained from the Conservation Division or its agents before plugging was commenced? Yes

Name of Conservation Agent who supervised plugging of this well W. L. Lackamp
Producing formation _____ Depth to top _____ Bottom _____ Total Depth of Well 4853 Feet
Show depth and thickness of all water, oil and gas formations.

OIL, GAS OR WATER RECORDS

CASING RECORD

FORMATION	CONTENT	FROM	TO	SIZE	PUT IN	PULLED OUT
				8 5/8"	283'	

Describe in detail the manner in which the well was plugged, indicating where the mud fluid was placed and the method or methods used in introducing it into the hole. If cement or other plugs were used, state the character of same and depth placed, from _____ feet to _____ feet for each plug set.
Well was filled with heavy mud from 4853' to 220'.
Plug at 220'
Globe Oil Well Cementing Co., pumped 50 sacks cement on top of plug.
Cement filled surface pipe to the top of the hole.

(If additional description is necessary, use BACK of this sheet)
Name of Plugging Contractor Bachus Oil Company
Address 721 East Central, Wichita, Kansas

STATE OF KANSAS, COUNTY OF SEDGWICK, ss.
Wm. A. Cecil, Gen. Mgr. (employee of owner) or (owner or operator) of the above-described well, being first duly sworn on oath, says: That I have knowledge of the facts, statements, and matters herein contained and the log of the above-described well as filed and that the same are true and correct. So help me God.

(Signature) [Signature]
Wm. A. Cecil, Gen. Mgr.
721 East Central, Wichita, Kansas
(Address)

SUBSCRIBED AND SWORN TO before me this 17th day of November, 19 58
Gail L. Thyfault
Gail L. Thyfault Notary Public.

My commission expires 10-19-60

PLUGGING
FILE SEC 35 T. 34 R. 13w
BOOK PAGE 144 LINE 32

11-18-58
1958
11-13-1958
CONSERVATION DIVISION
Wichita, Kansas

DRILLING LOG

COMPANY: Bachus Oil Company
721 East Central
Wichita, Kansas

LEASE: GOOD "A"

WELL: #1

LOCATION: Center SW/4 SE/4 of Section 35-34S-13W
Barber County, Kansas

DATE COMM: 10-26-58

DATE COMP: 11-9-58

T. D.: 4853'

CASING: 8 5/8" to 283' W/225 sacks common cement 2% CaCl.

Figures Indicate the Bottom of Formation

0-283	Red Bed, Sand and Shells
1110	Red Bed, Shells and Shale
1495	Shale and Shells
1645	Shale and Lime
1785	Lime and Shale
2055	Lime.
2240	Lime and Shale
2330	Lime
2355	Lime and Shale
2570	Shale and Lime
2760	Lime and Shale
2930	Shale and Lime
3200	Lime and Shale
3365	Shale and Lime
3500	Lime and Shale
3615	Shale and Lime Sandy
3815	Sandy Shale and Sand
3960	Sandy Shale
4070	Shale and Lime
4435	Lime
4474	Lime and Chert
4510	Cherty Lime
4534	Lime
4597	Lime and Chert
4610	Lime
4645	Lime and Shale
4686	Lime
4730	Shale and Lime
4763	Shale and Lime
4780	Sand and Lime
4824	Lime and Chert
4853	Mississippi

RECEIVED
STATE CORPORATION COMMISSION

NOV 22 1958

COMMISSION

I certify the above to be true and correct to the best of my knowledge and belief.

BACHUS OIL COMPANY

BY Wm. A. Cecil
Wm. A. Cecil, Gen. Mgr.

Subscribed and sworn before me this 10th day of November, 1958.
My Commission Expires:

October 19, 1960

Gail L. Thyfault
Gail L. Thyfault, Notary Public

PLUGGING

FILE SEC 35 T 34 R 13W
BOOK PAGE 144 LINE 32