


15-007-00597-0000

STATE OF KANSAS  
STATE CORPORATION COMMISSION

Give All Information Completely  
Make Required Affidavit  
Mail or Deliver Report to:  
Conservation Division  
State Corporation Commission  
211 No. Broadway  
Wichita, Kansas

WELL PLUGGING RECORD

NORTH

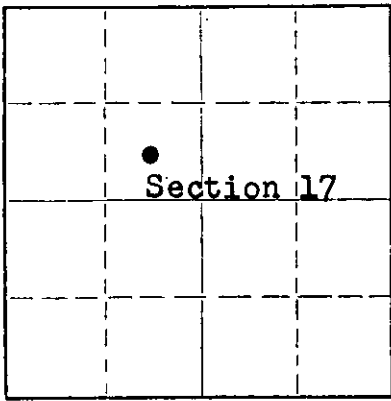

Locate well correctly on above  
Section Plat

Barber County. Sec. 17 Twp. 33 Rge. 14 (X) W (W)  
Location as "NE/CNW/SW" or footage from lines. C. SE NW  
Lease Owner Petroleum, Inc.  
Lease Name McGrath Well No. 1  
Office Address Route 2, Great Bend, Kansas  
Character of Well (completed as Oil, Gas or Dry Hole) Dry hole  
Date well completed February 17 19 58  
Application for plugging filed February 17 19 58  
Application for plugging approved February 17 19 58  
Plugging commenced February 17 19 58  
Plugging completed February 17 19 58  
Reason for abandonment of well or producing formation No producible zones

If a producing well is abandoned, date of last production none 19       
Was permission obtained from the Conservation Division or its agents before plugging was commenced? Yes

Name of Conservation Agent who supervised plugging of this well W.L. LaKamp  
Producing formation ---- Depth to top -- Bottom -- Total Depth of Well 4850 Feet  
Show depth and thickness of all water, oil and gas formations.

OIL, GAS OR WATER RECORDS

CASING RECORD

FORMATION	CONTENT	FROM	TO	SIZE	PUT-IN	PULLED OUT
				8 5/8"	1095'	none

Describe in detail the manner in which the well was plugged, indicating where the mud fluid was placed and the method or methods used in introducing it into the hole. If cement or other plugs were used, state the character of same and depth placed, from      feet to      feet for each plug set.

Mud up with heavy mud to 350', pushed down 1/3 sack hulls to 350' followed by a wooden plug. Placed 20 sacks cement through drill pipe on to plug. Mud up to 95' and placed 1/3 sack hulls at 35' followed by a wooden plug and 10 sacks cement to base of well cellar.

RECEIVED  
STATE CORPORATION COMMISSION  
FEB 20 1958  
2-20-58  
CONSERVATION DIVISION  
Wichita, Kansas

(If additional description is necessary, use BACK of this sheet)  
Name of Plugging Contractor Garvey Drilling Company  
Address Route 2, Great Bend, Kansas

STATE OF KANSAS, COUNTY OF BARTON, ss.  
Don Searle (employee of owner) or (~~agent~~) of the above-described well, being first duly sworn on oath, says: That I have knowledge of the facts, statements, and matters herein contained and the log of the above-described well as filed and that the same are true and correct. So help me God.

(Signature) Don Searle  
Route 2, Great Bend, Kansas  
(Address)

SUBSCRIBED AND SWORN to before me this 19th day of February, 19 58  
Ed J. Brown  
Notary Public.

My commission expires July 11, 1960

PLUGGING  
17T 33R 14W  
BOOK PAGE 83 LINE 40

15-007-00597-0000  
WELL LOG

COMPANY PETROLEUM, INCORPORATED

SEC. 17 T. 33S. 14W

FARM McGRATH NO. 1


LOC. C-SE, NW

TOTAL DEPTH 4850'

COUNTY BARBER CO., KANSAS

COMM. January 31, 1958 COMP. February 17, 1958

CONTRACTOR GARVEY DRILLING COMPANY

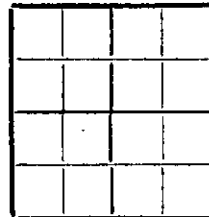

CASING 8 5/8" @ 1095' W/350 sax.

ELEVATION 1795' DF

PRODUCTION D & A

FIGURES INDICATE BOTTOM OF FORMATIONS

40	Gyp
750	Red bed & gyp
770	Shells & red bed
1110	Shale & lime
1200	Shale, lime & shells
1670	Shale & shells
1790	Shale & lime streaks
1850	Salt
2150	Lime & shale
2610	Lime
3710	Lime & shale
3865	Sand & shale
4105	Sand, shale & lime
4165	Sand & shale
4275	Lime
4330	Lime & shale
4432	Lime
4455	Lime & chert
4725	Lime
4742	Sand & shale
4758	Lime, shale & chert
4769	Chert
4850	Lime
4850	T. D.

RECEIVED  
STATE CORPORATION COMMISSION

FEB 20 1958  
2-20-58  
CONSERVATION DIVISION  
Wichita, Kansas

DRILLING  
FILE SEC. 17 T. 33 R. 14W  
BOOK PAGE 83 LINE 40

State of KANSAS )  
County of BARTON ) ss:

I, VERNE A. MORRIS of GARVEY DRILLING COMPANY

upon oath state that the above and foregoing is a true and correct copy of the log of the #1 McGRATH well

Verne A. Morris

Subscribed and sworn to before me this 18th day of February 19 58

My Commission Expires: July 11, 1960

Jed J. Brewer  
NOTARY PUBLIC