


Give All Information Completely  
Make Required Affidavit  
Mail or Deliver Report to:  
Conservation Division  
State Corporation Commission  
211 No. Broadway  
Wichita, Kansas

WELL PLUGGING RECORD

Barber County. Sec. 14 Twp. 33S Rge. 14 (E) 14 (W)

Location as "NE/CNW/SW" or footage from lines NE SW SW  
Lease Owner K & E DRILLING, INC.  
Lease Name Baier Well No. 1  
Office Address 719 Union Center Building, Wichita, Kansas  
Character of Well (completed as Oil, Gas or Dry Hole) Dry HL.  
Date well completed 2-18-64 19\_\_\_\_  
Application for plugging filed 2-24-64 19\_\_\_\_  
Application for plugging approved 2-20-64 19\_\_\_\_  
Plugging commenced 2-18-64 19\_\_\_\_  
Plugging completed 2-18-64 19\_\_\_\_  
Reason for abandonment of well or producing formation DRY

NORTH

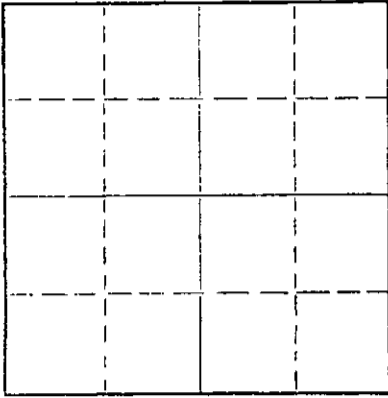

Locate well correctly on above  
Section Plat

If a producing well is abandoned, date of last production \_\_\_\_\_ 19\_\_\_\_  
Was permission obtained from the Conservation Division or its agents before plugging was commenced? yes

Name of Conservation Agent who supervised plugging of this well Archie Elving, Pratt, Kansas  
Producing formation \_\_\_\_\_ Depth to top \_\_\_\_\_ Bottom \_\_\_\_\_ Total Depth of Well 4760 Feet  
Show depth and thickness of all water, oil and gas formations.

OIL, GAS OR WATER RECORDS

CASING RECORD

FORMATION	CONTENT	FROM	TO	SIZE	PUT IN	PULLED OUT
				10-3/4"	225'	-0-

Describe in detail the manner in which the well was plugged, indicating where the mud fluid was placed and the method or methods used in introducing it into the hole. If cement or other plugs were used, state the character of same and depth placed, from \_\_\_\_\_ feet to \_\_\_\_\_ feet for each plug set.

Heavy mud to 240' - 1 sx. hulls & wooden plug, run 35 sx. cement  
Heavy mud to 40' - 1 sx hulls & wooden plug, run 15 sx. cement  
Used 2 sx. cement to plug rat hole

RECEIVED  
STATE CORPORATION COMMISSION

FEB 27 1964

2-27-64

CONSERVATION DIVISION  
Wichita, Kansas

(If additional description is necessary, use BACK of this sheet)

Name of Plugging Contractor K & E Drilling, Inc.  
Address 719 Union Center Building, Wichita 2, Kansas

STATE OF Kansas, COUNTY OF Sedgwick, ss.

H. L. Wilson (employee of owner) or (~~owner~~) of the above-described well, being first duly sworn on oath, says: That I have knowledge of the facts, statements, and matters herein contained and the log of the above-described well as filed and that the same are true and correct. So help me God.

(Signature) H. L. Wilson  
719 Union Center, Wichita, Kansas  
(Address)

SUBSCRIBED AND SWORN to before me this 26th day of February, 1964

My commission expires August 30, 1965

Julene M. Bannon  
Julene M. Bannon  
Notary Public.



# DRILLER'S WELL LOG

OPERATOR: **K & E DRILLING, INC.**  
**719 Union Center Building**  
**Wichita 2, Kansas**

WELL NAME: **#2 BAIER**  
 LOCATION: **NE SW SW**  
**Section 14-33S-14W**  
**Barber County, Kansas**

CONTRACTOR: **K & E DRILLING, INC.**  
**719 UNION CENTER BLDG.**  
**WICHITA, KANSAS**

COMMENCED: **February 5, 1964**  
 COMPLETED: **February 18, 1964**

CASING RECORD: **10-3/4" @ 225' w/175sx.**

ELEVATION: **1758 DF**  
**1761 KB**

ROTARY TOTAL DEPTH: **4760'**

PRODUCTION: **D & A**

## FORMATION RECORD

*Depths shown indicate bottom of formations encountered.*

Red bed & Shale	200
Shale	230
Sand & Shale	625
Shale & Shells	1575
Shale, Shells & Lime	1950
Shale & Lime	2690
Shale	2880
Shale & Lime	4120
Lime	4235
Lime & Chert	4265
Lime	4365
Lime & Chert	4415
Lime	4670

  
**RECEIVED**  
 STATE CORPORATION COMMISSION  
 FEB 27 1964  
 2-27-64  
 CONSERVATION DIVISION  
 Wichita, Kansas

## CERTIFICATION

State of KANSAS }  
 County of SEDGWICK } ss:

I, H. L. Wilson, of K&E DRILLING, INC., upon oath state that the above and foregoing is a true and correct copy of the Driller's Log of the above named well.

Subscribed and sworn to before me this 24th day of February 19 64

My Commission expires: August 30, 1965

H. L. Wilson  
 H. L. Wilson  
Julene M. Bannan  
 Julene M. Bannan Notary Public.

