

15-007-00136-0000

STATE OF KANSAS
STATE CORPORATION COMMISSION


WELL PLUGGING RECORD

Give All Information Completely
Make Required Affidavit
Mail or Deliver Report to:
Conservation Division
State Corporation Commission
800 Bittig Building
Wichita, Kansas

Barber County, Sec. 14 Twp. 33 Rge. (E) 14 (W)

Location as "NE/CNW&SWX" or footage from lines NW/NW/NW
Lease Owner Purcell-Mull Drilling Co., Inc.
Lease Name Angel Well No. 1
Office Address 6427 East Kellogg, Wichita, Kansas
Character of Well (completed as Oil, Gas or Dry Hole)
Date well completed 19
Application for plugging filed 19
Application for plugging approved 19
Plugging commenced 6-11- 19 55
Plugging completed 6-18- 19 55
Reason for abandonment of well or producing formation

NORTH

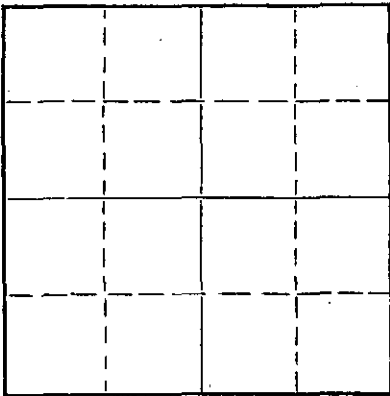

Locate well correctly on above
Section Plat

If a producing well is abandoned, date of last production 19
Was permission obtained from the Conservation Division or its agents before plugging was commenced? yes

Name of Conservation Agent who supervised plugging of this well M. A. Rives
Producing formation Depth to top Bottom Total Depth of Well 4762 Feet
Show depth and thickness of all water, oil and gas formations.

OIL, GAS OR WATER RECORDS

CASING RECORD

FORMATION	CONTENT	FRDM	TD	SIZE	PUT IN	PULLED OUT
				8 5/8"	345'	None
				5 1/2"	4761'	3465'

Describe in detail the manner in which the well was plugged, indicating where the mud fluid was placed and the method or methods used in introducing it into the hole. If cement or other plugs were used, state the character of same and depth placed, from feet to feet for each plug set.

Plugging started 6-11-55 and completed 6-18-55. Measured in to TD 4762'.

Plugged off bottom and rocked back to 4625'. Dumped in 5 sacks of cement;

shot pipe at 3465' and pulled pipe out of hole. Filled hole with heavy mud

to 300'; set permanent rock bridge; dumped in 20 sacks of cement; and filled

hole with heavy mud to 35' of top. Set permanent rock bridge and dumped in

10 sacks of cement for cap on well.

RECEIVED
STATE CORPORATION COMMISSION
JUN 25 1955
6-25-55
CONSERVATION DIVISION
WICHITA, KANSAS

(If additional description is necessary, use BACK of this sheet)
Name of Plugging Contractor Forbes Casing Pulling Co., d/b/a J. O. Forbes
Address P. O. Box 221, Great Bend, Kansas

STATE OF Kansas, COUNTY OF Sedgwick, ss.
Frank H. Purcell (employee of owner) or (owner or operator) of the above-described well, being first duly sworn on oath, says: That I have knowledge of the facts, statements, and matters herein contained and the log of the above-described well as filed and that the same are true and correct. So help me God.

(Signature) Frank H. Purcell
6405 E. Kellogg, Wichita 18, Kansas (Address)

ETHEL ZIMMERMAN
NOTARY PUBLIC
WICHITA, KANSAS
SUBSCRIBED AND SWORN TO before me this 24th day of June, 1955
My commission expires January 28, 1957

Ethel Zimmerman
Notary Public.

PLUGGING
FILE SEC. 14 T. 33 R. 14W
BOOK PAGE 125 LINE 37

ROTARY DRILLERS LOG

COMPANY : Purcell-Mull Drilling Co., Inc. ROTARY DRILLING COMMENCED: 4-20-55
Wichita, Kansas

CONTRACTOR : Purcell-Mull Drilling Co., Inc. ROTARY DRILLING COMPLETED: 5-6-55
Wichita, Kansas

CASING RECORD: 345' of New 8 5/8" Surface Csg. cemented with 200 sacks of cement
Set New 5 1/2" 15.5# csg. @ 4761' cemented with 200 sacks cement


LOCATION: ANGELL NO. 1
NW NW NW, Sec. 14-33S-14W
Barber County, Kansas

(Figures indicate bottom of formation - measurements from top of Rotary Bushing.)

Red Bed & Shale	345	Lime & Shale	3601
Shale & Shells	1350	Shale & Lime	3989
Shale & Lime	1523	Lime & Shale	4045
Lime & Shale	1920	Sand & Shale	4080
Lime	2572	Shale & Sand	4173
Lime & Shale	2686	Lime	4661
Shale & Lime	3232	Lime & Shale	4745
Lime & Shale	3320	Lime	4762 R.T.D.
Shale & Lime	3514		


I hereby certify that this is a true and correct copy of the above log to the best of my knowledge.

PURCELL-MULL DRILLING CO., INC.

 SECRETARY

STATE OF KANSAS)
) SS
COUNTY OF SEDGWICK)

Subscribed and sworn to before me this 10th day of May, 1955.

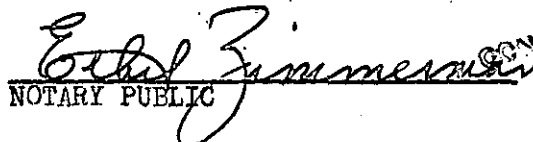
NOTARY PUBLIC

RECEIVED
STATE CORPORATION COMMISSION
JUN 25 1955
6-25-55
GENERAL INVESTIGATIVE DIVISION
Wichita, Kansas

MY COMMISSION EXPIRES: January 28, 1957.

PLUGGING
WEL SEC 14 T 33 R 1410
BOOK PAGE 125 LINE 37