

15-007-00269-0000

STATE OF KANSAS  
STATE CORPORATION COMMISSION

WELL PLUGGING RECORD

Give All Information Completely  
Make Required Affidavit  
Mail or Deliver Report to:  
Conservation Division  
State Corporation Commission  
211 No. Broadway  
Wichita, Kansas

Barber County, Sec. 36 Twp. 33 Rge. (E) 13 (W)

Location as "NE/CNW/SW" or footage from lines SE SE NW

Lease Owner Petroleum, Inc.

Lease Name HOLMES Well No. 1

Office Address 311 East Third, Wichita, Kansas

Character of Well (completed as Oil, Gas or Dry Hole) Dry Hole

Date well completed March 8 1956

Application for plugging filed March 8 1956

Application for plugging approved March 8 1956

Plugging commenced March 8 1956


Plugging completed March 8 1956

Reason for abandonment of well or producing formation

Dry Hole

If a producing well is abandoned, date of last production 19

Was permission obtained from the Conservation Division or its agents before plugging was commenced? yes

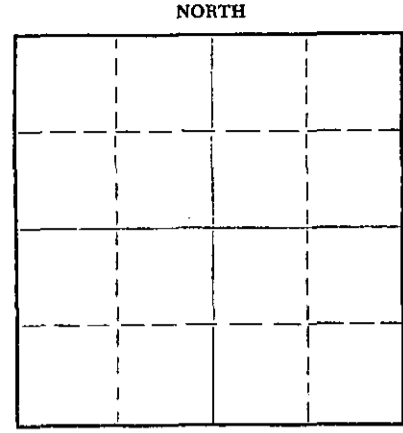

Locate well correctly on above  
Section Plat

Name of Conservation Agent who supervised plugging of this well Mr. M. A. Rives

Producing formation \_\_\_\_\_ Depth to top \_\_\_\_\_ Bottom \_\_\_\_\_ Total Depth of Well 4720 Feet

Show depth and thickness of all water, oil and gas formations.

OIL, GAS OR WATER RECORDS

CASING RECORD

FORMATION	CONTENT	FROM	TO	SIZE	PUT IN	PULLED OUT
				8-5/8"	282'	None

Describe in detail the manner in which the well was plugged, indicating where the mud fluid was placed and the method or methods used in introducing it into the hole. If cement or other plugs were used, state the character of same and depth placed, from \_\_\_\_\_ feet to \_\_\_\_\_ feet for each plug set.

Mudded up to 275' and set wooden plug preceded

by 1/3 sack hulls and followed by 20 sacks cement displaced

through drill pipe. Mudded up to 30' and set second wooden

plug preceded by 1/3 sack hulls and followed by 10 sacks

cement filling hole to base of well cellar.

(If additional description is necessary, use BACK of this sheet)

Name of Plugging Contractor Garvey Drilling Company

Address R. R. #2 - Great Bend, Kansas

STATE OF KANSAS, COUNTY OF SEDGWICK, ss.

Cullen Thomas (employee of owner) or (owner or operator) of the above-described well, being first duly sworn on oath, says: That I have knowledge of the facts, statements, and matters herein contained and the log of the above-described well as filed and that the same are true and correct. So help me God.

(Signature) Cullen Thomas

311 East Third, Wichita, Kansas  
(Address)

SUBSCRIBED AND SWORN TO before me this 9th day of March, 1956

Frances Sloan  
Notary Public.

My commission expires September 2, 1959

FRANCES SLOAN, Notary Public  
My Commission expires Sept. 2, 1959

**PLUGGING**  
FILE SEC 36 T 33 R 13W  
BOOK PAGE 44 LINE 13

3-21-56

COMPANY **Petroleum, Inc.**

SEC. **36** T. **33S** R. **13W**

FARM **HOLMES** NO. **1**


LOC. **SE SE NW**  
**2310' FWL**  
**2310' FWL**

TOTAL DEPTH **4720'**

COUNTY **Barber**

COMM. **February 22, 1956** COMP. **March 8, 1956**

CONTRACTOR **Garvey Drilling Company**

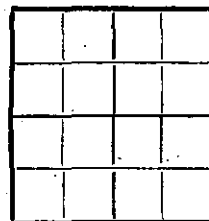

CASING **8-5/8" @ 232' w/250 sax**

ELEVATION **1529' DF**  
**1531' EB**

PRODUCTION **D & A**

FIGURES INDICATE BOTTOM OF FORMATIONS

283 Sand & Red Bed  
585 Shale & Red Bed  
850 Shale & Red Bed  
1400 Shale & Shells  
1645 Shale  
1960 Shale & Lime  
2090 Lime  
2205 Lime & Shale  
2495 Lime  
2615 Lime & Shale  
2925 Lime  
3060 Lime & Shale  
3360 Lime  
3495 Lime & Shale  
3670 Lime  
3790 Lime & Sandy Shale  
4720 Lime

Sample Tops

Elgin 3570 (-2039)  
Heebner 3743 (-2212)  
Douglas 3764 (-2233)  
Lansing 3930 (-2399)  
BKC 4113 (-2882)  
Mississippi 4568 (-3037)

RTD 4720'

RECEIVED  
STATE CORP  
CONCERN  
3-21-56

State of Kansas }  
County of Sedgwick }

I, Cullen Thomas of Petroleum, Inc.

upon oath state that the above and foregoing is a true and correct copy of the log of the HOLMES #1 well

Cullen Thomas

Subscribed and sworn to before me this 15th day of March 19 56

My Commission Expires: September 2, 1959

Frances Sloan  
NOTARY PUBLIC

**PLUGGING**  
FILE SEC 36 T 33 R 13W  
BOOK PAGE 44 LINE 13

FRANCES SLOAN, Notary Public  
My Commission expires Sept. 2, 1959