


15-007-2009-0000

STATE OF KANSAS
STATE CORPORATION COMMISSION

Form CP-4

Give All Information Completely
Make Required Affidavit
Mail or Deliver Report to:
Conservation Division
State Corporation Commission
212 No. Market
Wichita, Kansas

WELL PLUGGING RECORD

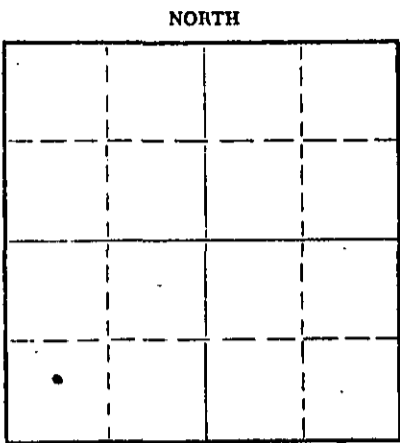

Locate well correctly on above
Section Plat

Barber County. Sec. 8 Twp. 33S Rge. - (E) 13 (W)
Location as "NE/CNWSW" or footage from lines 150' N of C of SW-SW
Lease Owner Shenandoah Oil Corporation
Lease Name Lavon Thompson Hoefle Well No. 1
Office Address 406 Mutual Savings Bldg., Fort Worth, Texas
Character of Well (completed as Oil, Gas or Dry Hole) Dry Hole
Date well completed May 19 19 67
Application for plugging filed May 24 19 67
Application for plugging approved Verbal approval on May 19, 19 67
Plugging commenced May 19 19 67
Plugging completed 7:00 A.M. May 20, 19 67
Reason for abandonment of well or producing formation No commercial
shows.

If a producing well is abandoned, date of last production Dry Hole 19
Was permission obtained from the Conservation Division or its agents before plugging was commenced? Yes

Name of Conservation Agent who supervised plugging of this well Mr. Archie Elving, Pratt, Kansas
Producing formation Simpson Depth to top 5134' Bottom 5220' Total Depth of Well 5220 Feet
Show depth and thickness of all water, oil and gas formations.

OIL, GAS OR WATER RECORDS

CASING RECORD

FORMATION	CONTENT	FROM	TO	SIZE	PUT IN	PULLED OUT
Douglas	Water	4078	4142	8-5/8"	290'	None
Simpson	Water	5162	5220			

Describe in detail the manner in which the well was plugged, indicating where the mud fluid was placed and the method or methods used in introducing it into the hole. If cement or other plugs were used, state the character of same and depth placed, from feet to feet for each plug set.

Hole filled with heavy mud to 260 feet. Bridged at 260 feet with plug, hulls and cement. Spotted 25 sack cement plug at 260 feet. Filled hole to 40 feet with heavy mud. Spotted 10 sack cement plug above bridge of hulls and dry cement. 2 sacks of cement spotted in rat hole.

RECEIVED
STATE CORPORATION COMMISSION
MAY 29 1967
5-29-67
CONSERVATION DIVISION
Wichita, Kansas

(If additional description is necessary, use BACK of this sheet)

Name of Plugging Contractor S & S Drilling Company.
Address Great Bend, Kansas

STATE OF Texas, COUNTY OF Tarrant, ss.
Harold E. Burke (employee of owner) or (owner or operator) of the above-described well, being first duly sworn on oath, says: That I have knowledge of the facts, statements, and matters herein contained and the log of the above-described well as filed and that the same are true and correct. So help me God.

(Signature) Harold E. Burke
406 Mutual Savings Bldg., Fort Worth, Texas
(Address)

SUBSCRIBED AND SWORN TO before me this 26th day of May, 1967

Dorice Benson
Notary Public.

My commission expires June 1, 1967

DRILLER'S LOG

Company: Shenandoah Oil Corporation
 Contractor: S & S Drilling Company
 Lease: Lavon Thompson Hoefle No. 1
 Location: 150' North of Center of SW SW
 Section 8, T33S R13W
 Barber County, Kansas
 Commenced: May 4, 1967
 Completed: May 20, 1967

0	180	Surface sand shale
180	290	Red bed
290	1185	Red bed and shale
1185	1416	Shale and anhydrite
1416	1945	Shale and lime streaks
1945	2635	Shale and lime
2635	2800	Shale and lime streaks
2800	3546	Shale and lime
3546	4188	Lime and shale
4188	4839	Lime
4839	4905	Lime and shale
4905	5078	Lime and shale
5078	5134	Lime
5134	5220	Shale and sand
5220		Total depth

RECEIVED
 STATE CORPORATIONS COMMISSION

MAY 29 1967
 5-29-67
 CONSERVATION DIVISION
 Wichita, Kansas

8-5/8" 20# casing cemented at 290 feet with 225 sacks Posmix with 3% HA-5.

I, Harold E. Burke, do hereby certify that the above and foregoing is a true and correct copy of the log of the Lavon Thompson Hoefle No. 1, located 150' North of Center of SW-SW, Section 8, T33S, R13W, Barber County, Kansas, as reflected by the drilling records of S & S Drilling Company.

Harold E. Burke
 Harold E. Burke

State of Texas

County of Tarrant

Subscribed and sworn to and before me, a Notary Public, in and for Tarrant County, Texas, this 25th day of May, 1967.

Gene Benson

My Commission Expires:

June 1, 1967

15-007-2009-0000

WELL LOG
Hoeble #1
C SW SW 8-338-13W
Barber County, Kansas

FROM	TO	
0	290	Sand and Redbed
290	1185	Redbed and Shale
1185	1416	Shale
1416	4240	Shale & lime
4240	4839	lime
4839	5078	Mississippi lime
5078	5220	Viola lime
5220		Total Depth

Elevation: 1862' K.B.

Formation Tops

Keebner	3952
Toronto	4002
Douglas	4034
Lansing K.C.	4180
Base K.C.	4590
Mississippi	4703
Kinderhook	4932
Viola	5012
Simpson	5134

RECEIVED
STATE CORPORATION COMMISSIONER

MAY 25 1967
5-25-67
CONSERVATION DIVISION
Wichita, Kansas

STATE OF KANSAS

COUNTY OF BARTON ss

T. D. Sweetman, Partner of B & S Drilling Company, being first duly sworn on oath says: That I have knowledge of the facts, statements and matters herein contained and the log of the above described well as filed and that the same are true and correct.

T. D. Sweetman
T.D. Sweetman

Subscribed and sworn before me this 23rd day of May, 1967

Karla L. Boyd
Notary Public Barton County

My Commission Expires 5/9/71