FORM CP-4


15-077-20507-00-00

original

* STATE OF KANSAS
STATE CORPORATION COMMISSION

WELL PLUGGING RECORD

Give All Information Completely
Make Required Affidavit
Mail or Deliver Report to
Conservation Division
State Corporation Comm.
245 North Water
Wichita, KS 67202

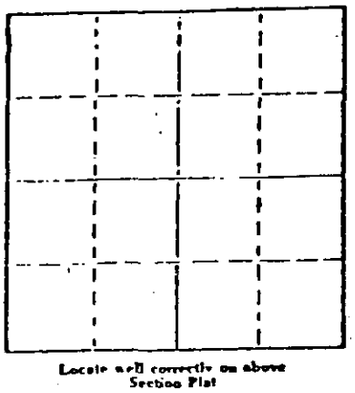

Locate well correctly on above Section Plat

Harper County. Sec. 8 Twp. 34S Rge. 9W E/W

Location as "NE/CNW¼SW¼" or footage from lines

C-SW SE

Lease Owner W. L. Kirkman, Inc.

Lease Name Woodworth Well No. 1

Office Address P. O. Box 18611, Wichita, Kansas 67207

Character of Well (Completed as Oil, Gas or Dry Hole)

Dry Hole

Date Well completed February 9, 1979

Application for plugging filed Verbal Application 19

Application for plugging approved Verbal Approval 19

Plugging commenced February 9, 1979

Plugging completed February 9, 1979

Reason for abandonment of well or producing formation

If a producing well is abandoned, date of last production 19

Was permission obtained from the Conservation Division or its agents before plugging was commenced? Yes

Name of Conservation Agent who supervised plugging of this well Wm. T. Owen

Producing formation Depth to top Bottom Total Depth of Well 4,701'

Show depth and thickness of all water, oil and gas formations.

OIL, GAS OR WATER RECORDS — CASING RECORD

FORMATION	CONTENT	FROM	TO	SIZE	PUT IN	PULLED OUT
				8-5/8"	278'	None

Describe in detail the manner in which the well was plugged, indicating where the mud fluid was placed and the method or methods used in introducing it into the hold. If cement or other plugs were used, state the character of same and depth placed, from feet to feet for each plug set.

Filled hole with heavy rotary mud from 4,701 ft. (rotary total depth) to 300 ft. Set plug at 300 ft. and cemented with 40 sacks cement. Filled hole with heavy rotary mud from 300 ft. to 40 ft. Set solid plug at 40 ft. and cemented to cellar with 12 sacks cement, 3 sacks cement in rat hole.

Plugging operations accomplished utilizing Halliburton Oil Well cementing pump truck through 4½ inch drill pipe.

(If additional description is necessary, use BACK of this sheet)

Name of Plugging Contractor Halliburton Services
410 Union Center Bldg., Wichita, Kansas 67202

RECEIVED
STATE CORPORATION COMMISSION
FEB 22 1979
CONSERVATION DIVISION
Wichita, Kansas

STATE OF Kansas COUNTY OF Sedgwick ss.

Dean Britting, Agent XXXXXXX of owner XXXXXXXXXXXXXXXXXXXXX) of the above-described well, being first duly sworn on oath, says: That I have knowledge of the facts, statements, and matters herein contained and the log of the above-described well as filed and that the same are true and correct. So help me God.

(Signature) Dean Britting

200 N Main, Wichita, Kansas 67202
(Address)

SUBSCRIBED AND SWORN TO before me this 19th day of February, 1979

Elsie Willison
Elsie Willison - Notary Public.

My commission expires July 25, 1982

API No. 15-077-20,507

KANSAS DRILLERS LOG

COMPANY W. L. Kirkman, Inc.

SEC. 8 T. 34S R. 9W
LOC. C-SW SE

FARM Woodworth NO. 1

COUNTY. Harper

ROTARY TOTAL DEPTH 4,701'
COMM. January 27, 1979 COMP. February 9, 1979
CONTRACTOR H-30, Inc. (Rig #5)
ISSUED February 19, 1979

CASING

10 3/4"
8 5/8" Set at 288' cemented w/235 sxs cement
5 1/2"
4 1/2"

ELEVATION 1,318' K.B.

FIGURES INDICATE BOTTOM OF FORMATIONS

Red Bed and Shale	1,460'
Shale and Lime	2,320'
Lime and Shale	2,470'
Shale and Lime	2,670'
Lime and Shale	3,645'
Lime	4,015'
Lime and Shale	4,630'
Lime	4,701'
Rotary Total Depth	4,701'

I hereby certify the above and foregoing to be a true and correct log of the above described well as shown by the drilling reports:

H-30, Inc.

Dean Britting

Dean Britting

State of Kansas }
County of Sedgwick } ss:

RECEIVED
STATE CORPORATION COMMISSION
FEB 20 1979
CONSERVATION DIVISION
Wichita, Kansas

Subscribed and Sworn to before me a Notary Public in and for said county and state this 19th day of February, 1979.

Elsie Willison

Elsie Willison - Notary Public

My Commission Expires:

July 25, 1982