
15-077-20604-00-00

FORM CP-4

STATE OF KANSAS
STATE CORPORATION COMMISSION

WELL PLUGGING RECORD

Give All Information Completely
Make Required Affidavit
Mail or Deliver Report to
Conservation Division
State Corporation Comm.
245 North Water
Wichita, KS 67202

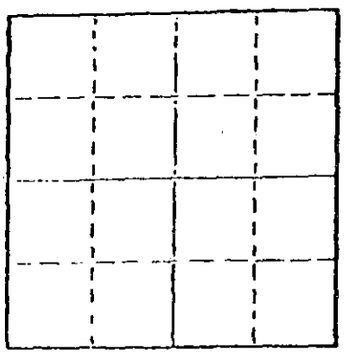

Locate well correctly on above Section Plat

Harper County. Sec. 8 Twp. 34S Rge. 9W E/W
Location as "NE/CNW¼SW¼" or footage from lines
660' FEL & 660' FNL (C NE NE)
Lease Owner W. L. Kirkman, Inc.
Lease Name Ricke Well No. 1
Office Address P. O. Box 18611, Wichita, Kansas 6720
Character of Well (Completed as Oil, Gas or Dry Hole)
Dry Hole
Date Well completed July 11, 1980
Application for plugging filed Verbal Application 19
Application for plugging approved Verbal Approval 19
Plugging commenced July 11, 1980
Plugging completed July 11, 1980
Reason for abandonment of well or producing formation

If a producing well is abandoned, date of last production 19
Was permission obtained from the Conservation Division or its agents before plugging was commenced? Yes
Name of Conservation Agent who supervised plugging of this well William T. Owen
Producing formation Depth to top Bottom Total Depth of Well 4,600'
Show depth and thickness of all water, oil and gas formations.

OIL, GAS OR WATER RECORDS — CASING RECORD

FORMATION	CONTENT	FROM	TO	SIZE	PUT IN	PULLED OUT
				8-5/8"	288'	None

Describe in detail the manner in which the well was plugged, indicating where the mud fluid was placed and the method or methods used in introducing it into the hold. If cement or other plugs were used, state the character of same and depth placed, from feet to feet for each plug set.

Filled hole with heavy rotary mud from 4,600 ft. (rotary total depth) to 270 ft. Set plug at 270 ft. and cemented with 40 sacks cement. Filled hole with heavy rotary mud from 270 ft. to 40 ft. Set solid plug at 40 ft. and cemented to cellar with 10 sacks cement, 5 sacks cement in rat hole.

Plugging operations accomplished utilizing Allied Oil Well cementing pump truck through 4½ inch drill pipe.

(If additional description is necessary, use BACK of this sheet)
Name of Plugging Contractor Allied Cementing Co., Inc.
Box 31, Russell, Kansas 67665

STATE OF Kansas COUNTY OF Sedgwick, ss.
Dean Britting, Agent (employee of owner) or (owner or operator) XXXXXXXXXX XXXXXXXXXXXXXXXXXXXXXX of the above-described well, being first duly sworn on oath, says: That I have knowledge of the facts, statements, and matters herein contained and the log of the above-described well as filed and that the same are true and correct. So help me God.

(Signature) Dean Britting
251 N. Water #10 Wichita, Kansas 6720
(Address)

SUBSCRIBED AND SWORN TO before me this 25th day of July, 1980

Elsie Willison
Elsie Willison - Notary Public.

My commission expires July 25, 1982

RECEIVED
STATE CORPORATION COMMISSION
AUG - 4 1980
8-4-80
CONSERVATION DIVISION
Wichita, Kansas

API No. 15-077-20,604

KANSAS DRILLERS LOG

COMPANY W. L. Krikman, Inc.

FARM Ricke NO. 1

SEC. 8 T. 34S R. 9W
LOC. 660' FEL & 660' FNL
(C NE NE)

COUNTY Harper

ROTARY TOTAL DEPTH 4,600'
COMM. July 1, 1980 COMP. July 11, 1980
CONTRACTOR H-30, Inc. (Rig #3)
ISSUED July 25,1980

CASING

10 3/4"
8 5/8" Set at 288' cemented w/250 sxs cement
5 1/2"
4 1/2"

ELEVATION 1,313' K.B.

FIGURES INDICATE BOTTOM OF FORMATIONS

Red Bed and Shale	1,542'
Lime and Shale	1,995'
Shale and Lime	2,235'
Lime and Shale	4,600'
Rotary Total Depth	4,600'

I hereby certify the above and foregoing to be a true and correct log of the above described well as shown by the drilling reports.

H-30, INC.

Dean Britting
Dean Britting

State of Kansas)
) ss:
County of Sedgwick)

Subscribed and Sworn to before me a Notary Public in and for said county and state this 25th day of July, 1980.

Elsie Willison
Elsie Willison - Notary Public

My Commission Expires:

July 25, 1982

RECEIVED
STATE CORPORATION COMMISSION
AUG - 4 1980
CONSERVATION DIVISION
Wichita, Kansas