15-077-20764-00-00

STATE OF KANSAS
STATE CORPORATION COMMISSION
200 Colorado Derby Bldg.
Wichita, Kansas 67202


Form CP-4
Rev. 12-15-80

RECEIVED
STATE CORPORATION COMMISSION
2-8-82
FEB - 8 1982
CONSERVATION DIVISION
Wichita, Kansas

WELL PLUGGING RECORD

Give All Information Completely
Make Required Affidavit

COUNTY Harper SEC. 8 TWP. 34S RGE. 9W E/W
Location as in quarters or footage from lines:
C NW NE

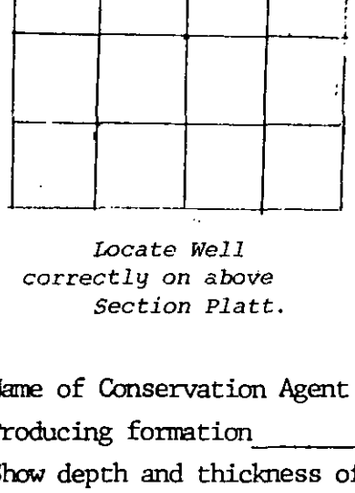

Locate Well correctly on above Section Platt.

Lease Owner Geoson Oil Co.
Lease Name J. Frank (Ricke) Well No. 1
Office Address 212 N. Market, Suite 508, Wichita, Ks. 67202
Character of Well (Completed as Oil, Gas or Dry Hole): Dry
Date Well Completed January 2, 1982
Application for plugging filed Yes
Plugging commenced 18:30 2 January 1982
Plugging completed 21:15 2 January 1982
Reason for abandonment of well or producing formation
Dry
Was permission obtained from the Conservation Division or it's Agent's before plugging was commenced? Yes

Name of Conservation Agent who supervised plugging of this well Maurice Leslie
Producing formation _____ Depth to top _____ bottom _____ T.D. 4626
Show depth and thickness of all water, oil and gas formations.

OIL, GAS OR WATER RECORDS — Casing Record

Formation	Content	From	To	Size	Put in	Pulled Out

Describe in detail the manner in which the well was plugged, indicating where the mud fluid was placed and the method or methods used in introducing it into the hold. If cement or other plugs were used, state the character of same and depth placed, from _____ feet to _____ feet for each plug set.

Plug @ 620' set with 60 sacks
Plug @ 285' set with 40 sacks
Plug @ 40' set with 10 sacks
Plug rat hole set with 10 sacks
Plug mouse hole set with 5 sacks with Class H, 2% gel, 3% CaCl
Displaced with fresh water

(If additional description is necessary, use BACK of this sheet)
Name of Plugging Contractor Dowell Div., Dow Chemical Co., Hwy. 281 & Santa Fe, Pratt, Ks. 67124

STATE OF Kansas COUNTY OF Sedgwick, ss.
Charles W. Dixon (employee of owner) or (owner or operator) of the above-described well, being first duly sworn on oath, says: That I have knowledge of the facts, statements, and matters herein contained and the log of the above-described well as filed and that the same are true and correct. So help me God.

(Signature) Charles W. Dixon
212 N. Market, Wichita, Kansas
(Address)

SUBSCRIBED AND SWORN TO before me this 3th day of February, 19 82

Rita Jeter Notary Public.

My Commission expires: March 25, 1985