


STATE OF KANSAS
STATE CORPORATION COMMISSION
CONSERVATION DIVISION
P. O. BOX 17027
WICHITA, KANSAS 67217

FORM CP-4

WELL PLUGGING RECORD

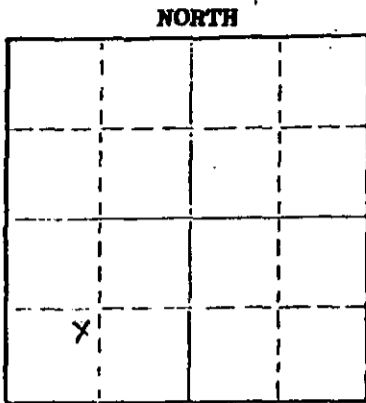

Harper County, Sec 3 Twp 34S Rge 9 (E) W (W)
Location as "NE/CNW/SW" or footage from lines NE SW SW
Lease Owner Robinson Oil Co. ; Wichita, Ks. 67202
Lease Name Dombaugh 'A' Well No. #1
Office Address 340 R. H. Garvey Building
Character of Well (completed as Oil, Gas or Dry Hole) Dry Hole
Date well completed July 17 1974
Application for plugging filed November 18 1974
Application for plugging approved November 19 1974
Plugging commenced November 25 1974
Plugging completed November 27 1974
Reason for abandonment of well or producing formation Dry & Abandoned

If a producing well is abandoned, date of last production 19
Was permission obtained from the Conservation Division or its agents before plugging was commenced? Yes

Name of Conservation Agent who supervised plugging of this well Russell Riberstein
Producing formation Mississippian Depth to top 4559 Bottom 4604 Total Depth of Well 4604 Feet
Show depth and thickness of all water, oil and gas formations.

OIL, GAS OR WATER RECORDS

CASING RECORD

FORMATION	CONTENT	FROM	TO	SIZE	PUT IN	PULLED OUT
				8 5/8"	241	None
				4 1/2"	4584	3798

Describe in detail the manner in which the well was plugged, indicating where the mud fluid was placed and the method or methods used in introducing it into the hole. If cement or other plugs were used, state the character of same and depth placed, from _____ feet to _____ feet for each plug set.

November 25, 1974 Plugged off bottom. Dumped sand to 4100', Mixed and dumped 4 sx of cement.
November 27, 1974 Plugged off top. Set 10' rock bridge at 320'. Filled surface casing and hole from 320' to base of cellar with 3000 lb. P.S.I. ready-mix concrete.

(If additional description is necessary, use BACK of this sheet)

Name of Plugging Contractor RUSS CASING PULLING, INC.
Address P. O. Box 1082 ; Great Bend, Kansas 67530

STATE OF Kansas COUNTY OF Sedgwick ss.
Dale M. Robinson (employee or owner) or (owner or operator) of the above-described

well, being first duly sworn on oath, says: That I have knowledge of the facts, statements, and matters herein contained and the log of the above-described well as filed and that the same are true and correct. So help me God.

(Signature) Dale M. Robinson
Dale M. Robinson
340 R. H. Garvey Bldg., Wichita, Kansas
(Address)

SUBSCRIBED AND SWORN to before me this 8th day of January, 1975 67202

My commission expires Esther Lamone
NOTARY PUBLIC
Sedgwick County, Kansas
Com. Expires Jan. 19, 1977

Esther Lamone
Esther Lamone Notary Public

RECEIVED
STATE CORPORATION COMMISSION
JAN 9 1975
CONSERVATION DIVISION
Wichita, Kansas

WELL LOG
Dombaugh A #1
NE SW SW 3-34-9W
Harper County, Kansas

Name Of Operator: Robinson & Sweetman
335 R. H. Garvey Bldg.- 300 West Douglas
Wichita, Kansas 67202

Date Completed: May 31, 1974


<u>FROM</u>	<u>TO</u>	
0	10	Sand
10	400	Red bed and shale
400	1151	Shale
1151	3806	Lime and shale
3806	3878	Stal. Sand
3878	4080	Lime & shale
4080	4600	KC Lime
4600	4610	Miss.
4610		Total Depth

RECEIVED
STATE CORPORATION COMMISSION
NOV 19 1974
CONSERVATION DIVISION
Wichita, Kansas

STATE OF KANSAS

COUNTY OF BARTON ss

Gary L. Hawk, Secretary of Sweetman Drilling, Inc., being first duly sworn on oath says: That I have knowledge of the facts, statements and matters herein contained and the log of the above described well as filed and that the same are true and correct.

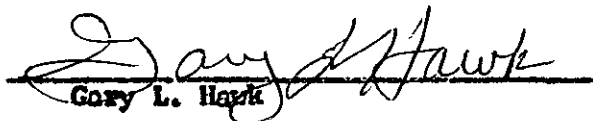
Gary L. Hawk

Subscribed and sworn before me this 5th day of June, 1974.


Notary Public Barton County

My Commission Expires 7-10-77

