
FORM CP-4

15-077-20694-00-00

STATE OF KANSAS
STATE CORPORATION COMMISSION

WELL PLUGGING RECORD

Give All Information Completely
Make Required Affidavit
Mail or Deliver Report to
Conservation Division
State Corporation Comm.
245 North Water
Wichita, KS 67202

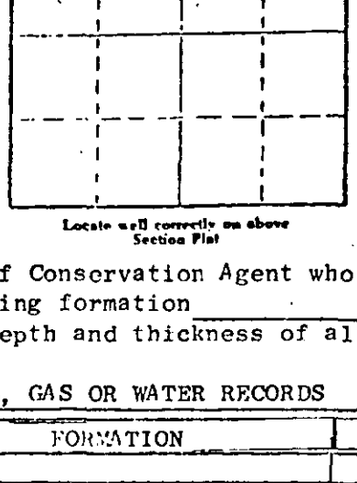

Locate well correctly on above Section Plat

Harper County. Sec. 3 Twp. 34S Rge. 9W E/W
Location as "NE/CNW¼SW¼" or footage from lines
C NW NW
Lease Owner Columbine Exploration
Lease Name Jones Well No. 1
Office Address Guarantee Bank Bldg, 817 17th St, Denver, Co
Character of Well (Completed as Oil, Gas or Dry Hole) Dry
Date Well completed 7-3 19 81
Application for plugging filed 7-3 19 81
Application for plugging approved 7-3 19 81
Plugging commenced 7-3 19 81
Plugging completed 7-3 19 81
Reason for abandonment of well or producing formation Dry
If a producing well is abandoned, date of last production 19
Was permission obtained from the Conservation Division or its agents before plugging was commenced? Yes

Name of Conservation Agent who supervised plugging of this well Maurice Lestley
Producing formation Depth to top Bottom Total Depth of Well 4650
Show depth and thickness of all water, oil and gas formations.

OIL, GAS OR WATER RECORDS — CASING RECORD

FORMATION	CONTENT	FROM	TO	SIZE	PUT IN	PULLED OUT
		0	250	8 5/8		

Describe in detail the manner in which the well was plugged, indicating where the mud fluid was placed and the method or methods used in introducing it into the hold. If cement or other plugs were used, state the character of same and depth placed, from feet to feet for each plug set. Plugged:
50 sacks @ 520
40 sacks @ 250
10 sacks @ 40
10 sacks in rathole; 5 sacks in mousehole
Cemented by Allied Cementing
Completed 11:00 PM 7-3-81

RECEIVED
STATE CORPORATION COMMISSION
AUG 10 1981
8-10-81
CONSERVATION DIVISION
Wichita, Kansas

(If additional description is necessary, use BACK of this sheet)
Name of Plugging Contractor DaMac Drilling Inc.
Box 1164, Great Bend, Ks. 67530

STATE OF Kansas COUNTY OF Barton, ss.
Martha J. McKown (employee of owner) or (owner or operator) of the above-described well, being first duly sworn on oath, says: That I have knowledge of the facts, statements, and matters herein contained and the log of the above-described well as filed and that the same are true and correct. So help me God.

(Signature) Martha J McKown
Box 1164, Great Bend, Kansas 67530
(Address)

SUBSCRIBED AND SWORN TO before me this 3rd day of July, 1981

VADA I. SULLIVAN
Barton County, Kansas
My Appt. Exp. 2-3c-84

Vada I. Sullivan
Notary Public.

My commission expires

WELL LOG

COMPANY Columbine Exploration

SEC. 3 T. 34S R. 9W

FARM Jones NO. 1

LOC. C NW NW

TOTAL DEPTH 4650RTD

COUNTY Harper, Ks.

COMM. 6-26-81 COMP. 7-3-81

CONTRACTOR DaMac Drilling Inc.

CASING 8 5/8 set @ 225'

ELEVATION

PRODUCTION P&A

FIGURES INDICATE BOTTOM OF FORMATIONS

Sand, RedBed	0	40
RedBed, Shale	40	707
Shale	707	1610
Shale, Lime	1610	4650 RTD

RECEIVED
STATE CORPORATION COMMISSION
AUG 10 1981
CONSERVATION DIVISION
Wichita Kansas

State of Kansas } ss
County of Barton }

I, Martha J. McKown of DaMac Drilling Inc.

upon oath state the above and foregoing is a true and correct copy of the log of the Jones #1 well.

Martha J. McKown

Subscribed and sworn to before me this 3rd day of July 19 81.

My Commission Expires: VADA L. SULLIVAN Barton County, Kansas My Appt. Exp. 1-30-84

Vada L. Sullivan
NOTARY PUBLIC