


WELL PLUGGING RECORD

Give All Information Completely
Make Required Affidavit
Mail or Deliver Report to:
Conservation Division
State Corporation Commission
212 North Market, Insurance Bldg.
Wichita, Kansas

Harper County, Sec. 16 Twp. 34S Rge. 9W (E) (W)

Location as "NE/CNW/SW" or footage from lines C NE SE
Lease Owner The Oil Capitol Corporation
Lease Name Woodworth Well No. 1
Office Address First National Building, Tulsa, Oklahoma
Character of Well (completed as Oil, Gas or Dry Hole) Dry Hole
Date well completed September 20, 1962
Application for plugging filed September 20, 1962
Application for plugging approved September 20, 1962
Plugging commenced September 20, 1962
Plugging completed September 20, 1962
Reason for abandonment of well or producing formation no oil and/or gas found in commercial quantities.
If a producing well is abandoned, date of last production 19
Was permission obtained from the Conservation Division or its agents before plugging was commenced? yes

NORTH

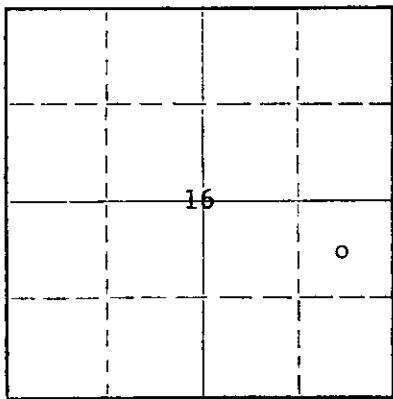

Locate well correctly on above Section Plat

Name of Conservation Agent who supervised plugging of this well Herman Justus
Producing formation _____ Depth to top _____ Bottom _____ Total Depth of Well _____ Feet
Show depth and thickness of all water, oil and gas formations.

OIL, GAS OR WATER RECORDS

CASING RECORD

FORMATION	CONTENT	FROM	TO	SIZE	PUT IN	PULLED OUT
				8-5/8"	266'	None

Describe in detail the manner in which the well was plugged, indicating where the mud fluid was placed and the method or methods used in introducing it into the hole. If cement or other plugs were used, state the character of same and depth placed, from _____ feet to _____ feet for each plug set.

Filled hole with extra heavy rotary mud from total depth to 180'. Set plug #1 and 20 sx. cement. Filled hole with extra heavy rotary mud from Plug #1 to 38'. Set plug #2 @ 38' and 8 sacks cement.

RECEIVED
STATE CORPORATION COMMISSION
10-10-62
OCT 10 1962
CONSERVATION DIVISION
Wichita, Kansas

(If additional description is necessary, use BACK of this sheet)

Name of Plugging Contractor Prime Drilling Company
Address 814 Union Center, Wichita, Kansas

STATE OF KANSAS, COUNTY OF SEDGWICK, ss.
R. R. McNicol, employee of Prime Drilling Company of the above-described well, being first duly sworn on oath, says: That I have knowledge of the facts, statements, and matters herein contained and the log of the above-described well as filed and that the same are true and correct. So help me God.
(Signature) R. R. McNicol PRIME DRILLING COMPANY, DRILLING CONTRACTOR
814 UNION CENTER, WICHITA, KANSAS
(Address)

SUBSCRIBED AND SWORN TO before me this 2nd day of October, 19 62

Handa Low Bruce
Notary Public.

My commission expires March 6, 1965.



ROTARY DRILLING LOG

OPERATOR: Oil Capitol Corporation
LEASE: Woodworth #1
LOCATION: C NE SE Sec. 16-34-9W
Harper County, Kansas
COMMENCED: September 3, 1962
COMPLETED: September 20, 1962

CONTRACTOR: Prime Drilling Company
CASING: Set 8-5/8" surface pipe
@ 266' w/200 sx. cement.

FORMATIONS:

0 - 20	Sand
20 - 220	Red Bed
220 - 266	Red Bed & Shells
266 - 410	Shale
410 - 610	Red Bed & Shale
610 -1410	Shale & Shells
1410 -1460	Shale & Anhydrite
1460 -1590	Lime & Shale streaks
1590 -1965	Lime
1965 -2530	Lime & Shale
2530 -2680	Shale & Lime Streaks
2680 -3025	Lime & Shale
3025 - 3100	Shale & Lime Streaks
3100 -3264	Lime & Shale
3264 -3470	Shale & Lime
3470 -3550	Sand & Shale
3550 -3584	Shale & Lime
3584 -3798	Lime & Shale
3798 -3826	St. Sand
3826 -3973	Lime
3973 -4082	Shale & Sand
4082 -4178	Shale, Sand & Lime
4178 -4395	Lime
4395 -4505	Lime w/Shale streaks
4505 -4578	Lime & Shale
4578 -4628	Lime
4628 -4872	Mississippian Lime
4872 -4954	Shale & Sand
4954 -4986	Sandy Shale
4986 -5012	Lime, chert, shale
5012 -5039	Lime & Chert
5039 -5055	Sand & Cherty Dolomite
5055	Rotary Total Depth

D & A

RECEIVED
STATE CORPORATION COMMISSION

OCT 10 1962

CONSERVATION DIVISION
Wichita, Kansas

We certify the above log is true and correct to the best of our knowledge and belief.

PRIME DRILLING COMPANY
BY


R. R. McNicol