

FOR KCC USE:

CORRECTED INTENT AS TO LOCATION

FORM C-1 7/91
FORM MUST BE TYPED
FORM MUST BE SIGNED
ALL BLANKS MUST BE FILLED

EFFECTIVE DATE: 4-12-99
DISTRICT # 1
SGA Yes No X

State of Kansas
NOTICE OF INTENTION TO DRILL
Must be approved by the K.C.C. five (5) days prior to commencing well

Expected Spud Date 04 10 99
Month day year

Spot approx. 210' N of
SE SE Sec 10 Twp 33 S Rg 13 W West

* .540 feet from South North Line of Section

OPERATOR: LICENSE # 8061
Name: OIL PRODUCERS, INC. OF KANSAS
Address: P.O. BOX 8647
City/State/Zip: WICHITA, KANSAS 67208
Contact Person: JOHN S. WEIR/DIANA RICHECKY
Phone: 316-681-0231

.330 feet from East West Line of Section

IS SECTION X REGULAR IRREGULAR?
(Note: Locate well on the Section Plat on Reverse Side)

CONTRACTOR: License # 4958
Name: MALLARD JV, INC.

Lease Name: ROOT Well #: 1
Field Name: MEDICINE LODGE BOGGS

Is this a Prorated / Spaced Field? yes no

Target Formation (s): MISSISSIPPI

Nearest Lease or unit boundary: 330 WAS: 660'

Ground Surface Elevation: 1661 feet MSL

Water well within one - quarter mile: yes no

Public water supply well within one mile: yes no

Depth to bottom of fresh water: 100

Depth to bottom of usable water: 200

Surface Pipe by Alternate: X 1 2

Length of Surface Pipe Planned to be set: 400

Length of Conductor pipe required: 0

Projected Total Depth: 4600

Formation at Total Depth: Mississippi

Water Source for Drilling Operations: Well Farm Pond other

DWR Permit #:

Will Cores Be Taken?: yes no

If yes, proposed zone:

Well Drilled For: Well Class: Type Equipment:
Oil Enh Rec Infield Mud Rotary
Gas Storage Pool Extension Air Rotary
OWWO Disposal Wildcat Cable
Seismic: # of Holes Other

If OWWO: old well information as follows:
Operator:
Well Name:
Comp. Date: Old Total Depth

Directional, Deviated or Horizontal wellbore? yes x no
If yes, true vertical depth:
Bottom Hole Location:

AFFIDAVIT * WAS: 330' FSL IS: 540' FSL

The undersigned hereby affirms that the drilling, completion and eventual plugging of this well will comply with K.S.A. 55-101, et. seq. It is agreed that the following minimum requirements will be met. :

- 1. Notify the appropriate district office prior to spudding of well;
2. A copy of the approved notice of intent to drill shall be posted on each drilling rig;
3. The minimum amount of surface pipe as specified below shall be set by circulating cement to the top; in all cases surface pipe shall be set through all unconsolidated materials plus a minimum of 20 feet into the underlying formation;
4. If the well is dry hole, an agreement between the operator and the district office on plug lenth and placement is necessary prior to plugging;
5. The appropriate district office will be notified before well is either plugged or production casing is cemented in;
6. IF AN ALTERNATE II COMPLETION, PRODUCTION PIPE SHALL BE CEMENTED FROM BELOW ANY USABLE WATER TO SURFACE WITHIN 120 DAYS OF SPUD DATE. IN ALL CASES, NOTIFY DISTRICT OFFICE PRIOR TO ANY CEMENTING.

I hereby certify that the statements made herein are true and to the best of my knowledge and belief.

Date: 4/12/99 Signature of Operator or Agent: John S. Weir Title: President

FOR KCC USE:
API # 15- 007-225950000
Conductor pipe required NONE feet
Minimum surface pipe required 220 feet per Alt. 1 X
Approved by: COR 4-16-99 / DRIL 4-7-99 JK
This authorization expires: 10-7-99
(This authorization void if drilling not started within 6 months of effective date.)
Spud date: Agent:

REMEMBER TO:

- File Drill Pit Application (form CDP - 1) with Intent to Drill;
- File Completion Form ACO -1 within 120 days of spud date;
- File acreage attribution plat according to field proration orders;
- Notify appropriate district office 48 hours prior to workover or re-entry;
- Submit plugging report (CP-4) after plugging is completed;
- Obtain written approval before disposing or injecting salt water.

Mail to: KCC - Conservation Division, 130 S. Market - Room 2078, Wichita, Kansas 67202.

RECEIVED 10
APR 13 1999 33 13W
4-13-99
CONSERVATION DIVISION
Wichita, Kansas

IN ALL CASES PLOT THE INTENDED WELL ON THE PLAT BELOW

PLAT OF ACREAGE ATTRIBUTABLE TO A WELL IN A PRORATED OR SPACED FIELD

If the intended well is in a prorated or spaced field, please fully complete this side of the form. If the intended well is in a prorated or spaced field complete the plat below showing that the well will be properly located in relationship to other wells producing from the common source of supply. Please show all the wells within 1 mile of the boundaries of the proposed acreage attribution unit for gas wells and within 1/2 mile of the boundaries of the proposed acreage attribution unit for oil wells.

API NO. 15- _____
 OPERATOR OIL PRODUCERS, INC. OF KANSAS
 LEASE ROOT _____
 WELL NUMBER #1 _____
 FIELD _____

LOCATION OF WELL: COUNTY BARBER
 _____ 330 feet from south/north line of section
 _____ 330 feet from east/west line of section
 SECTION 10 TWP 33 S _____ RG 13 W


NUMBER OF ACRES ATTRIBUTABLE TO WELL 40
 QTR/QTR/QTR OF ACREAGE _____

IS SECTION X REGULAR or _____ IRREGULAR
IF SECTION IS IRREGULAR, LOCATE WELL FROM NEAREST CORNER BOUNDARY.

Section corner used: _____

PLAT

(Show location of the well and shade attributable acreage for prorated or spaced wells.)
 (Show footage to the nearest lease or unit boundary line.)

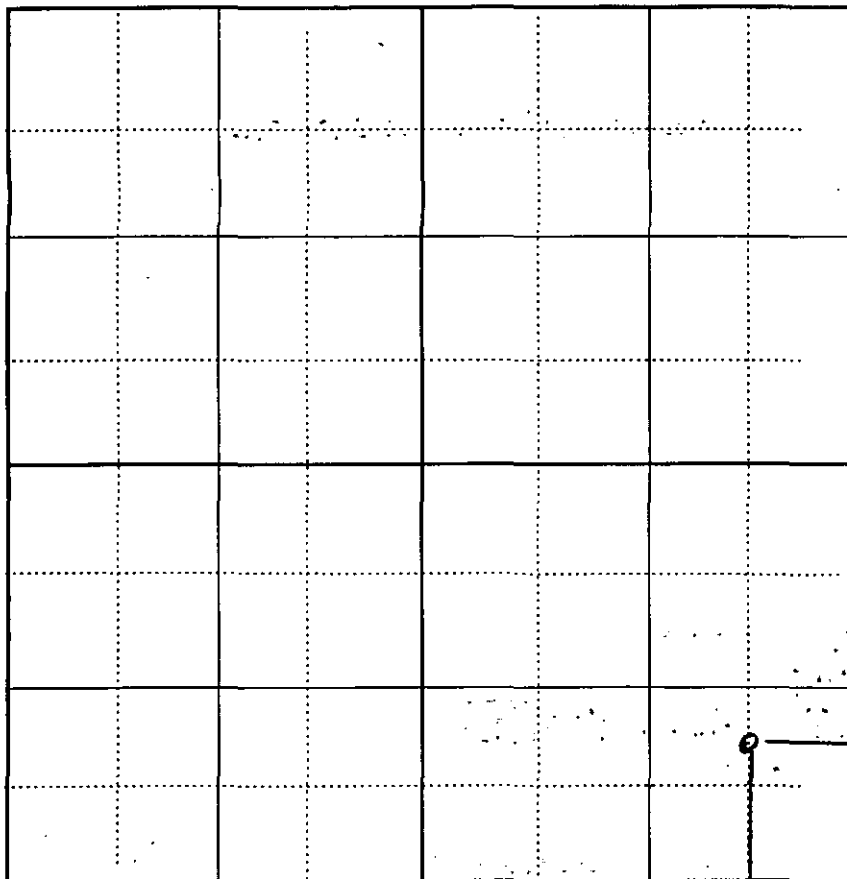


SECTION 10 BARBER COUNTY, KANSAS

RECEIVED


CONSERVATION DIVISION
 Wichita, Kansas

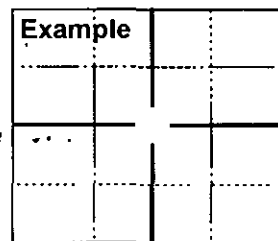

SEWARD CO.

In plotting the proposed location of the well, you must show:

- 1) The manner in which you are using the depicted plat by identifying section lines, i.e. 1 section, 1 section with 8 surrounding sections; 4 sections, etc.;
- 2) the distance of the proposed drilling location from the section's south/north and east/west; and
- 3) the distance to the nearest lease or unit boundary line.