

CARD MUST BE TYPED

State of Kansas  
**NOTICE OF INTENTION TO DRILL**  
(see rules on reverse side)

CARD MUST BE SIGNED

Starting Date: August 30, 1984  
month day year

API Number 15- 077-21,028-00-00

OPERATOR: License # 5601  
Name Associated Petroleum Consultants, Inc.  
Address Suite 600 - One Main Place  
City/State/Zip Wichita, Kansas 67202-1399  
Contact Person C. R. King  
Phone (316) 265-9385

E/2 E/2 NE Sec 16 Twp 34 S, Rge 6  
(Location)  East  West  
3960 Ft North from Southeast Corner of Section  
330 Ft West from Southeast Corner of Section  
(Note: Locate well on Section Plat on reverse side)

CONTRACTOR: License # 5867  
Name Heartland Drilling, Inc.  
City/State Wichita, Kansas

Nearest lease or unit boundary line 330 feet  
County Harper  
Lease Name Robb Well# 1

Well Drilled For: Well Class: Type Equipment:  
 Oil  Swd  Infield  Mud Rotary  
 Gas  Inj  Pool Ext.  Air Rotary  
 OWWO  Expl  Wildcat  Cable

Domestic well within 330 feet:  yes  no  
Municipal well within one mile:  yes  no

If OWWO: old well info as follows:  
Operator  
Well Name  
Comp Date Old Total Depth  
Projected Total Depth 4800' feet  
Projected Formation at TD Mississippi  
Expected Producing Formations Layton - Mississippi

Depth to Bottom of fresh water 200 feet  
Lowest usable water formation ~~Quaternary~~ Harper Sandstone  
Depth to Bottom of usable water 200 feet  
Surface pipe by Alternate: 1  2   
Surface pipe to be set 320' feet  
Conductor pipe if any required None feet  
Ground surface elevation 1265' feet MSL  
This Authorization Expires 2-16-85  
Approved By 8-16-84 R.C.

I certify that we will comply with K.S.A. 55-101, et seq., plus eventually plugging hole to K.C.C. specifications.

Date 8/15/84 Signature of Operator or Agent

Charles R. King  
CHARLES R. KING

President

MHC/MOHE 8/16/84


Must be filed with the K.C.C. five (5) days prior to commencing well  
This card void if drilling not started within six (6) months of date received by K.C.C.

RECEIVED  
STATE CORPORATION COMMISSION

AUG 16 1984

Important procedures to follow: CONSERVATION DIVISION  
Wichita, Kansas

**A Regular Section of Land**  
1 Mile = 5,280 Ft.

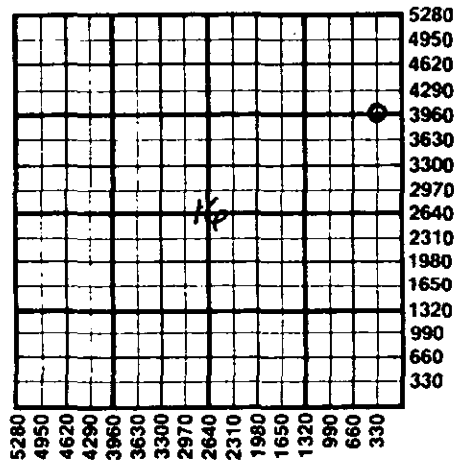

1. Notify District office before setting surface casing.
2. Set surface casing by circulating cement to the top.
3. File completion forms ACO-1 with K.C.C. within 90 days of well completion, following instructions on ACO-1, side 1, and including copies of wireline logs.
4. Notify District office 48 hours prior to old well workover or re-entry.
5. Prior to plugging, prepare a plugging plan, then obtain agreement from the appropriate district office for an approved plugging plan.
6. Submit plugging report (CP-4) to K.C.C. after plugging is completed.
7. Obtain an approved injection docket number before disposing of salt water.
8. Notify K.C.C. within 10 days when injection commences or terminates.
9. If an alternate 2 completion, cement in the production pipe from below any usable water to surface within 120 days of spud date.

State Corporation Commission of Kansas  
Conservation Division  
200 Colorado Derby Building  
Wichita, Kansas 67202  
(316) 263-3238