

CARD MUST BE TYPED

State of Kansas  
**NOTICE OF INTENTION TO DRILL**

CARD MUST BE SIGNED

Starting Date: September 15 1984  
month day year

API Number 15- 007-21913-0000  
*\*CORRECTION\* 9-13-84*

OPERATOR: License # 5171  
Name TXO Production Corp.  
Address 200 W. Douglas, Suite 300  
City/State/Zip Wichita, KS 67202  
Contact Person Gary Wurdeman  
Phone 316-265-9441

150' S. SE... SE... Sec. 26, Twp. 31. S, Rge 11.  East  
(Location)  West  
\* 510..... Ft North from Southeast Corner of Section  
\* 660..... Ft West from Southeast Corner of Section  
(Note: Locate well on Section Plat on reverse side)

CONTRACTOR: License # 6165  
Name FWA Drilling Co., Inc.  
City/State Yukon, OK

Nearest lease or unit boundary line 510..... feet.  
County Barber  
Lease Name CHAPIN-SMITH "A" Well# 1

Well Drilled For: Well Class: Type Equipment:  
 Oil  Swd  Infield  Mud Rotary  
 Gas  Inj  Pool Ext.  Air Rotary  
 OWWO  Expl  Wildcat  Cable

Domestic well within 330 feet:  yes  no  
Municipal well within one mile:  yes  no

If OWWO: old well info as follows:  
Operator .....  
Well Name .....  
Comp Date ..... Old Total Depth .....  
Projected Total Depth 4000..... feet  
Projected Formation at TD Lansing.....  
Expected Producing Formations Lansing.....

Depth to Bottom of fresh water 100..... feet  
Lowest usable water formation Harper Siltstone.....  
Depth to Bottom of usable water 200..... feet  
Surface pipe by Alternate: 1  2   
Surface pipe to be set 360..... feet  
Conductor pipe if any required 0..... feet  
Ground surface elevation TBD..... feet MSL  
This Authorization Expires 3-2-85.....

I certify that we will comply with K.S.A. 55-101, et seq., plus eventually plugging hole to K.C.C. specifications.

Date 9-13-84 Signature of Operator or Agent Gary Wurdeman Title District Engineer

*CS & SE 1980 FEL  
66 FSL*

RECEIVED

STATE CORPORATION COMMISSION **Must be filed with the K.C.C. five (5) days prior to commencing well**  
**This card void if drilling not started within six (6) months of date received by K.C.C.**


SEP 13 1984

9-13-84

WICHITA, KANSAS

**A Regular Section of Land**

**1 Mile = 5,280 Ft.**

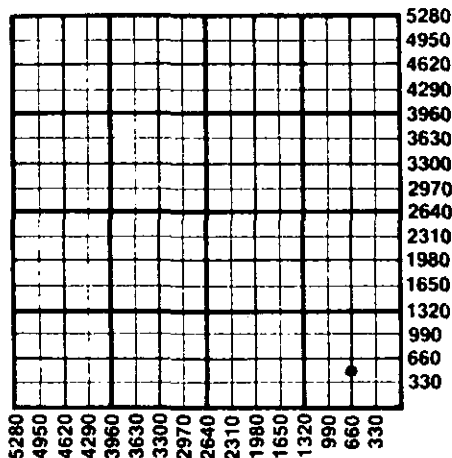

**Important procedures to follow:**

1. Notify District office before setting surface casing.
2. Set surface casing by circulating cement to the top.
3. File completion forms ACO-1 with K.C.C. within 90 days of well completion, following instructions on ACO-1, side 1, and including copies of wireline logs.
4. Notify District office 48 hours prior to old well workover or re-entry.
5. Prior to plugging, prepare a plugging plan, then obtain agreement from the appropriate district office for an approved plugging plan.
6. Submit plugging report (CP-4) to K.C.C. after plugging is completed.
7. Obtain an approved injection docket number before disposing of salt water.
8. Notify K.C.C. within 10 days when injection commences or terminates.
9. If an alternate 2 completion, cement in the production pipe from below any usable water to surface within 120 days of spud date.

**State Corporation Commission of Kansas**  
**Conservation Division**  
**200 Colorado Derby Building**  
**Wichita, Kansas 67202**  
**(316) 263-3238**