

CARD MUST BE TYPED

State of Kansas
NOTICE OF INTENTION TO DRILL
(see rules on reverse side)

CARD MUST BE SIGNED

Starting Date: September 25, 1984
month day year

API Number 15- 077-21,035-00-00

OPERATOR: License # 5003
Name McCoy Petroleum Corporation
Address 500 Heritage Park Place
City/State/Zip Wichita, Kansas 67202
Contact Person Roger McCoy
Phone 316 - 265-9697

C NE NW (location) Sec 25 Twp 33 S, Rge 8 East West

4620 Ft North from Southeast Corner of Section
3300 Ft West from Southeast Corner of Section
(Note: Locate well on Section Plat on reverse side)

CONTRACTOR: License # 5658
Name Sweetman Drilling, Inc.
City/State Wichita, Kansas 67202

Nearest lease or unit boundary line 660 feet.
County Harper
Lease Name Norman "A" Well# 1

Domestic well within 330 feet: yes no
Municipal well within one mile: yes no

Well Drilled For: Well Class: Type Equipment:
 Oil Swd Infield Mud Rotary
 Gas Inj Pool Ext. Air Rotary
 OWWO Expl Wildcat Cable

Depth to Bottom of fresh water 150 feet
Lowest usable water formation Permian
Depth to Bottom of usable water 200 feet
Surface pipe by Alternate: 1 2
Surface pipe to be set 250 feet
Conductor pipe if any required None feet
Ground surface elevation (Est.) 1380 feet MSL.
This Authorization Expires 3-20-85
Approved By 9-20-84 *hc*

If OWWO: old well info as follows:

Operator
Well Name
Comp Date 4750 Old Total Depth
Projected Total Depth feet
Projected Formation at TD Mississippian
Expected Producing Formations Mississippian

I certify that we will comply with K.S.A. 55-101, et seq., plus eventually plugging hole to K.C.C. specifications.


Date 9-19-84 Signature of Operator or Agent John Roger McCoy Title President

MHC/WONE 9/20/84

Must be filed with the K.C.C. five (5) days prior to commencing well
This card void if drilling not started within six (6) months of date received by K.C.C.

Important procedures to follow:

**A Regular Section of Land
1 Mile = 5,280 Ft.**

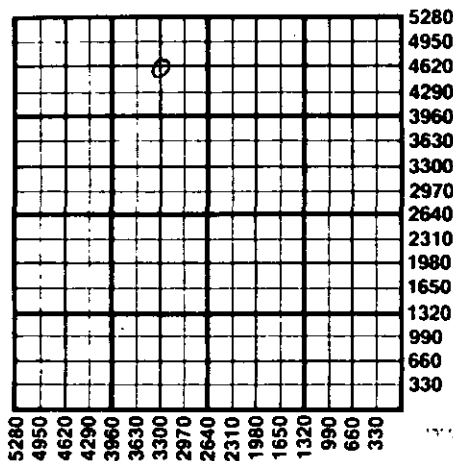

1. Notify District office before setting surface casing.
2. Set surface casing by circulating cement to the top.
3. File completion forms ACO-1 with K.C.C. within 90 days of well completion, following instructions on ACO-1, side 1, and including copies of wireline logs.
4. Notify District office 48 hours prior to old well workover or re-entry.
5. Prior to plugging, prepare a plugging plan, then obtain agreement from the appropriate district office for an approved plugging plan.
6. Submit plugging report (CP-4) to K.C.C. after plugging is completed.
7. Obtain an approved injection docket number before disposing of salt water.
8. Notify K.C.C. within 10 days when injection commences or terminates.
9. If an alternate 2 completion, cement in the production pipe from below any usable water to surface within 120 days of spud date.

RECEIVED

STATE CORPORATION COMMISSION

State Corporation Commission of Kansas

Conservation Division

200 Colorado Derby Building

Wichita, Kansas 67202

(316) 263-3238

SEP 20 1984

CONSERVATION DIVISION
Wichita, Kansas