

CARD MUST BE TYPED

State of Kansas
NOTICE OF INTENTION TO DRILL

CARD MUST BE SIGNED

(see rules on reverse side)

Starting Date: December 17, 1984
month day year

API Number 15- 007-21,969-00-00

OPERATOR: License # 5047
Name Rupe Oil Company, Inc.
Address P. O. Box 2273
City/State/Zip Wichita, Kansas 67201
Contact Person William G. Clement
Phone

E/2 NE SE Sec 27 Twp 30 S, Rge 12 East
(location) West
..... 1980 Ft North from Southeast Corner of Section
..... 330 Ft West from Southeast Corner of Section
(Note: Locate well on Section Plat on reverse side)

CONTRACTOR: License # 5148
Name Big H Drilling, Inc.
City/State Wichita, Kansas 67202

Nearest lease or unit boundary line 330 feet.
County Barber
Lease Name Meairs 'B' Well# 1

Well Drilled For: Well Class: Type Equipment:
 Oil Swd Infield Mud Rotary
 Gas Inj Pool Ext. Air Rotary
 OWWO Expl Wildcat Cable

Domestic well within 330 feet: yes no
Municipal well within one mile: yes no

If OWWO: old well info as follows:
Operator

Well Name

Comp Date Old Total Depth

Projected Total Depth 4750 feet

Projected Formation at TD Simpson Sand

Expected Producing Formations Douglas Sand, Mississippi and Viola

Depth to Bottom of fresh water feet
Lowest usable water formation feet
Depth to Bottom of usable water 200 ~~150~~ feet
Surface pipe by Alternate: 1 2
Surface pipe to be set 240 feet
Conductor pipe if any required feet
Ground surface elevation 1700 est. feet MSL
This Authorization Expires 5-26-85
Approved By 11-26-84 RC

I certify that we will comply with K.S.A. 55-101, et seq., plus eventually plugging hole to K.C.C. specifications.


Rupe Oil Company, Inc.
William G. Clement President

Nov. 21, 1984
Date Signature of Operator or Agent

Must be filed with the K.C.C. five (5) days prior to commencing well
 This card void if drilling not started within six (6) months of date received by K.C.C.

Important procedures to follow:

A Regular Section of Land
1 Mile = 5,280 Ft.

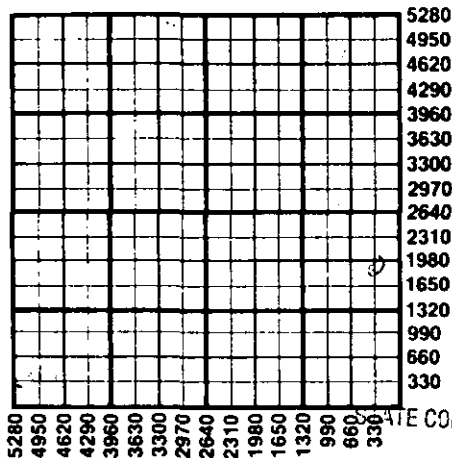

1. Notify District office before setting surface casing.
2. Set surface casing by circulating cement to the top.
3. File completion forms ACO-1 with K.C.C. within 90 days of well completion, following instructions on ACO-1, side 1, and including copies of wireline logs.
4. Notify District office 48 hours prior to old well workover or re-entry.
5. Prior to plugging, prepare a plugging plan, then obtain agreement from the appropriate district office for an approved plugging plan.
6. Submit plugging report (CP-4) to K.C.C. after plugging is completed.
7. Obtain an approved injection docket number before disposing of salt water.
8. Notify K.C.C. within 10 days when injection commences or terminates.
9. If an alternate 2 completion, cement in the production pipe from below any usable water to surface within 120 days of spud date.

RECEIVED
 STATE CORPORATION COMMISSION

State Corporation Commission of Kansas
 Conservation Division
 200 Colorado Derby Building
 Wichita, Kansas 67202
 (316) 263-3238

NOV 26 1984
 11-26-84
 CONSERVATION DIVISION
 Wichita, Kansas