

EFFECTIVE DATE: 8-27-91 *CORRECTED COPY

Correction

FORM MUST BE TYPED
FORM C-1 4/90

State of Kansas
NOTICE OF INTENTION TO DRILL

FORM MUST BE SIGNED
ALL BLANKS MUST BE FILLED

Must be approved by the K.C.C. five (5) days prior to commencing well

*App. 200' W.

N/2 SW SE Sec 28 Twp 31 S, Rg 11 East
X West

Expected Spud Date 9-10-91
month day year

990' feet from South line of Section
*2180' feet from East line of Section

(Note: Locate well on Section Plat on Reverse Side)

OPERATOR: License # 3372
Name: Morrison-Dixon Oil Operations, Inc.
Address: 155 N. Market, Suite 950
City/State/Zip: Wichita, Kansas 67202
Contact Person: Michael W. Dixon
Phone: (316) 264-9632

County: Barber

Lease Name: Colle Well #: 1

Field Name: Unnamed

Is this a Prorated Field? yes X no

Target Formation(s): Mississippi

Nearest lease or unit boundary: 330'

Ground Surface Elevation: 1636' feet MSL

Domestic well within 330 feet: yes X no

Municipal well within one mile: yes X no

Depth to bottom of fresh water: 125'

Depth to bottom of usable water: 180'

Surface Pipe by Alternate: X 1 2

Length of Surface Pipe Planned to be set: 225'

Length of Conductor pipe required: None

Projected Total Depth: 4600'

Formation at Total Depth: Mississippi

Water Source for Drilling Operations:

N.A. well farm pond other

DWR Permit #: _____

Will Cores Be Taken? yes X no

If yes, proposed zone: _____

CONTRACTOR: License #: 5418
Name: Allen Drilling

Well Drilled For: Well Class: Type Equipment:

X Oil ... Inj ... Infield ... Mud Rotary
X Gas ... Storage X Pool Ext. ... Air Rotary
... OWWO ... Disposal X Wildcat ... Cable
... Seismic; ... # of Holes

If OWWO: old well information as follows:

Operator: _____

Well Name: _____

Comp. Date: _____ Old Total Depth _____

Directional, Deviated or Horizontal wellbore? yes X no

If yes, total depth location: _____

WAS: 1980 FEL

AFFIDAVIT IS: 2180 FEL

The undersigned hereby affirms that the drilling, completion and eventual plugging of this well will comply with K.S.A. 55-101, et. seq.

It is agreed that the following minimum requirements will be met:

1. The appropriate district office shall be notified before setting surface pipe;
2. The minimum amount of surface pipe as specified above shall be set by circulating cement to the top; in all cases surface pipe shall be set through all unconsolidated materials plus a minimum of 20 feet into the underlying formation;
3. If the well is dry, a plugging proposal shall be submitted to the district office. An agreement between the operator and the district office on plug length and placement is necessary prior to plugging;
4. The appropriate district office will be notified before well is either plugged or production casing is cemented in;
5. If an Alternate II completion, production pipe shall be cemented from below any usable water to surface within 120 days of spud date. In all cases, notify district office prior to any cementing.

I hereby certify that the statements made herein are true and to the best of my knowledge and belief.

Date: 8-30-91 Signature of Operator or Agent: Michael W. Dixon Title: Vice-President

FOR KCC USE:

API # 15- 007-22,375-0000

Conductor pipe required None feet

Minimum surface pipe required 200 feet per Alt. (1) Do

Approved by: MWD 11-8-91 Aug 8-22-91

EFFECTIVE DATE: 8-27-91

This authorization expires: 2-22-92

(This authorization void if drilling not started within 6 months of effective date.)

Spud date: _____ Agent: _____

RECEIVED
STATE CORPORATION COMMISSION

NOV 1 1991
11-1-91
CONSERVATION DIVISION
Wichita, Kansas

Handwritten initials and numbers: 2, 3, 31, 11/1/91

REMEMBER TO:

- File Drill Pit Application (form CDP-1) with Intent to Drill;
- File Completion Form ACO-1 within 120 days of spud date;
- File acreage attribution plat according to field proration orders;
- Notify appropriate district office 48 hours prior to workover or re-entry;
- Submit plugging report (CP-4) after plugging is completed;
- Obtain written approval before disposing or injecting salt water.

RECEIVED


PLAT OF ACREAGE ATTRIBUTABLE TO A WELL

State Corporation Commission, Conservation Division
200 Colorado Derby Bldg. Wichita, Kansas 67202

OPERATOR Morrison-Dixon Oil Oper., Inc. LOCATION OF WELL:
 LEASE Colle #1 990' feet north of SE corner
 WELL NUMBER 1 *2180' feet west of SE corner
 FIELD SE/4 Sec. 28 T 31 R 11 E/W
 COUNTY Barber
 NO. OF ACRES ATTRIBUTABLE TO WELL 160 IS SECTION X REGULAR IRREGULAR?
 IF IRREGULAR, LOCATE WELL FROM NEAREST
 DESCRIPTION OF ACREAGE SE/4 CORNER BOUNDARY.

NOTE: If plat depicted is insufficient for your circumstances, you may attach your own scaled or surveyed plat.

PLAT

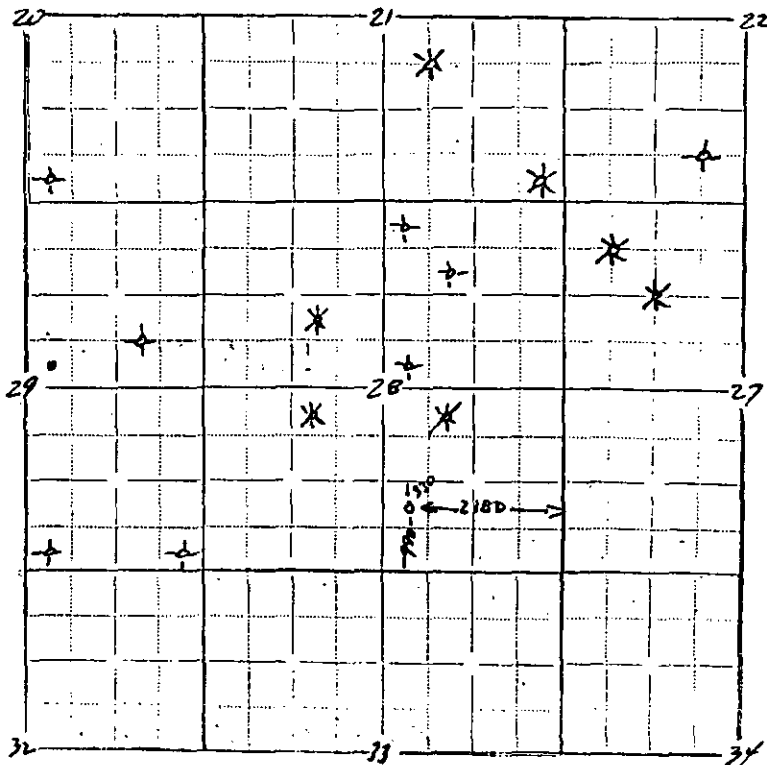

In plotting the proposed location of the well, you must show:

- 1) The manner in which you are using the depicted plat by identifying section lines, i.e. 1 section, 1 section with 8 surrounding partial sections, 4 sections, 16 sections, etc.;
- 2) the well's location relative to the location of other wells producing from the same common source of supply in adjoining drilling units, pursuant to K.A.R. 82-3-108, 82-3-207, 82-3-312, or special orders of the Commission;
- 3) the distance of the proposed drilling location from the section's east and south lines; and
- 4) the distance to the nearest lease or unit boundary line.

I hereby certify that the statements made herein are true and to the best of my knowledge and belief.

Signature of Operator or Agent Michael W. Dixon 10-31-91
 Date 8-30-91 Title Vice-President