


Give All Information Completely
Make Required Affidavit
Mail or Deliver Report to:
Conservation Division
State Corporation Commission
212 No. Market
Wichita, Kansas

WELL PLUGGING RECORD

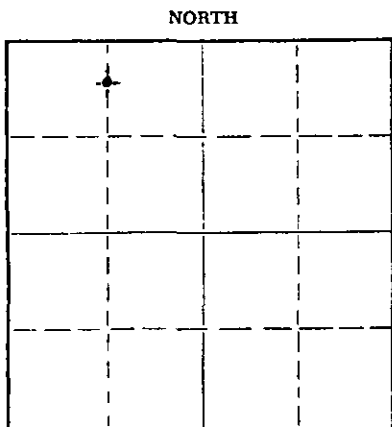

Locate well correctly on above
Section Plat

Barber County. Sec. 20 Twp. 31 Rge. 11 (E) (W) X
Location as "NE/CNW/SW" or footage from lines C N/2 N/2 NW
Lease Owner Bowers Drilling Company, Inc.
Lease Name Watkins A Well No. 1
Office Address 1434 Wichita Plaza Bldg.
Character of Well (completed as Oil, Gas or Dry Hole) Dry Hole
Date well completed October 31 19 69
Application for plugging filed October 31 19 69
Application for plugging approved verbal October 31 19 69
Plugging commenced October 31 19 69
Plugging completed October 31 19 69
Reason for abandonment of well or producing formation Dry Hole
If a producing well is abandoned, date of last production 19
Was permission obtained from the Conservation Division or its agents before plugging was commenced? Yes

Name of Conservation Agent who supervised plugging of this well R. J. Warren
Producing formation None Depth to top Bottom Total Depth of Well 4435 Feet
Show depth and thickness of all water, oil and gas formations.

OIL, GAS OR WATER RECORDS

CASING RECORD

| FORMATION | CONTENT | FROM | TO | SIZE | PUT IN | PULLED OUT |
|-----------|---------|------|----|------|--------|------------|
| | | | | | | |
| | | | | | | |
Describe in detail the manner in which the well was plugged, indicating where the mud fluid was placed and the method or methods used in introducing it into the hole. If cement or other plugs were used, state the character of same and depth placed, from feet to feet for each plug set.

First plug @ 315 25 sack cement
Second plug @ 401 70 sacks cement

RECEIVED
STATE CORPORATION COMMISSION
DEC 24 1969
CONSERVATION DIVISION
Wichita, Kansas

(If additional description is necessary, use BACK of this sheet)
Name of Plugging Contractor Bowers Drilling Company, Inc.
Address 1434 Wichita Plaza Bldg.

STATE OF KANSAS, COUNTY OF SEDGWICK, ss.
Emil E. Bowers (employee of owner) or (owner or operator) of the above-described well, being first duly sworn on oath, says: That I have knowledge of the facts, statements, and matters herein contained and the log of the above-described well as filed and that the same are true and correct. So help me God.

(Signature) Emil E. Bowers
1434 Wichita Plaza Bldg.

(Address)

SUBSCRIBED AND SWORN TO before me this 23rd day of December, 19 69

My commission expires May 12, 1973

Charles A. Young

Notary Public.

WELL LOG

COMPANY: Bowers Drilling Company, Inc.
 CONTRACTOR: Bowers Drilling Company, Inc.
 FARM: Watkins "A" #1
 LOCATION: C N/2 N/2 NW/4
 Sec. 20-31S-11W
 Barber County, Kansas
 COMMENCED: October 21, 1969
 COMPLETED: October 31, 1969
 ELEVATION: 1651 Kelly Bushing
 1649 Derrick Floor
 1645 Ground Level

| | | |
|-------------|------------------|-------------------------------|
| 0 - 320 | Redbed and shale | Set 8 5/8" at 319 w/275 saxes |
| 320 - 1355 | Shale | |
| 1355 - 1771 | Shale & shells | |
| 1771 - 2015 | Shale & lime | |
| 2015 - 2240 | Lime | |
| 2240 - 3815 | Shale & lime | |
| 3815 - 3988 | Lime | |
| 3988 - 4073 | Lime & shale | |
| 4073 - 4385 | Lime | |
| 4385 - 4436 | Miss. | |
| 4435 | T. D. | |

RECEIVED
 STATE CORPORATION COMMISSION
 DEC 24 1969
 12-24-69
 CONSERVATION DIVISION
 Wichita, Kansas

LOG TOPS:

| | |
|---------------------|------|
| Elgin Zone | 3433 |
| Elgin Sand | 3476 |
| Heebner | 3593 |
| Douglas | 3600 |
| Douglas Shaley Sand | 3611 |
| Douglas Clean Sand | 3687 |
| Lansing | 3791 |
| Mississippian | 4379 |

STATE OF KANSAS)
) SS
 COUNTY OF SEDGWICK)

I, Emil E. Bowers, do hereby certify that the above and foregoing is a true and correct copy of the log of the #1 Watkins "A" located C N/2 N/2 NW/4 Section 20-31S-11W, Barber County, Kansas, as reflected by the files of Bowers Drilling Company, Inc.


 Emil E. Bowers, President

Subscribed and sworn to before me, a Notary Public, in and for the State of Kansas, this 20th day of November, 1969.


 Carole A. Young, Notary Public

My commission expires May 12, 1973.

