


WELL PLUGGING RECORD

Give All Information Completely
Make Required Affidavit
Mail or Deliver Report to:
Conservation Division
State Corporation Commission
800 Bittig Building
Wichita, Kansas

Barber County. Sec. 20 Twp. 31 Rge. (E) 11 (W)

Location as "NE/CNW/SW" or footage from lines SW SW SW
Lease Owner Messman-Rinehart Oil Company
Lease Name Dryden Well No. 1
Office Address 518 Petroleum Bldg.
Character of Well (completed as Oil, Gas or Dry Hole) Gas
Date well completed May 15, 1957 19
Application for plugging filed February 25, 1957 19
Application for plugging approved February 25, 1957 19
Plugging commenced March 4, 1957 19
Plugging completed March 6, 1957 19
Reason for abandonment of well or producing formation Reservoir depleted

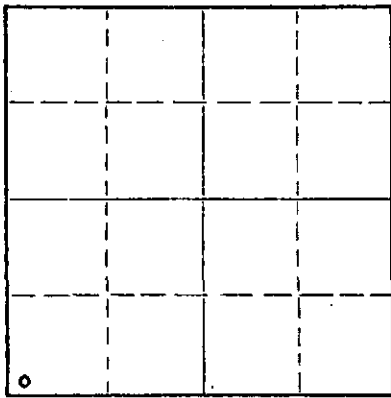

Locate well correctly on above Section Plat

If a producing well is abandoned, date of last production February 10, 1957 19
Was permission obtained from the Conservation Division or its agents before plugging was commenced? Yes

Name of Conservation Agent who supervised plugging of this well Maple Rives, Pratt, Kansas
Producing formation Douglas sd. Depth to top 3555 Bottom 3624 Total Depth of Well 4335 Feet
Show depth and thickness of all water, oil and gas formations.

OIL, GAS OR WATER RECORDS

CASING RECORD

FORMATION	CONTENT	FROM	TO	SIZE	PUT IN	PULLED OUT
				8 5/8"	138'	None
				5 1/2"	4330'	2600'

Describe in detail the manner in which the well was plugged, indicating where the mud fluid was placed and the method or methods used in introducing it into the hole. If cement or other plugs were used, state the character of same and depth placed, from _____ feet to _____ feet for each plug set.

Plugged back with crushed rock to 3585', dumped 5 sax cement at 3585 with dump bailer. Top of cement 3550'. Pumped in 75 sax Gel-Mud at 1800' by Globe Cementing Co. Filled hole with mud to 200', set rock bridge, dumped 40 sax cement. Top of cement 110'. Filled hole with mud to 35' set rock bridge, dumped 10 sax cement for cap.

(If additional description is necessary, use BACK of this sheet)

Name of Plugging Contractor Miller Casing Pulling Co.
Address P. O. Box 711, Great Bend, Kansas

STATE OF KANSAS, COUNTY OF SEDGWICK, ss.
J. A. Gilliland (employee of owner) or (owner or operator) of the above-described

well, being first duly sworn on oath, says: That I have knowledge of the facts, statements, and matters herein contained and the log of the above-described well as filed and that the same are true and correct. So help me God.

(Signature)

518 Petroleum Bldg., Wichita, Kansas
(Address)

SUBSCRIBED AND SWORN TO before me this 11th day of March, 1957

My commission expires September 5, 1960

Notary Public.

RECORDED 1957
3-13-57
CONSERVATION DIVISION
Wichita, Kansas

PLUGGING
FILE SEC. 20 T. 31 R. 11W
BOOK PAGE 143 LINE 28

DRYDEN # 1

WELL RECORD

Location: SW,SW,SW Sec. 20;Twp.31; E.11W
 Barber County, Kansas
 Operator: Graham-Messman-Rinehart Oil Co.
 1005 E. Second Street
 Wichita, Kansas

Commenced: April 3, 1953
 Completed: *May 5, 1953*
 Elevation: 1586 K. B.

Contractor: Graham-Messman-Rinehart

Production: *Yes*

Casing Record: 8 5/8" @ 138' WOC
 4 1/2" @ 4330 w/175 sx cement

LOG

(Figures indicate bottom of formation)

Clay & Shale	150
Shale	600
Shale	1184
Shale & Shells	1585
Shale & Shells	1825
Shale & Shells	1980
Shale & Lime	2090
Shale & Lime	2230
Shale & Lime	2336
Shale & Lime	2565
Shale & Lime	2740
Shale & Lime	2920
Shale & Lime	3040
Shale & Lime	3160
Shale & Lime	3305
Shale & Lime	3367
Shale & Lime	3440
Shale & Lime	3532
Shale & Lime	3555
Douglas Sand	3631
Sand	3670
Sand	3685
Sand & Shale	3731
Sand & Shale	3770
Kansas City-Lime	3818
Lime	3840
Lime	3875
Lime	3944
Lime	4009
Lime & Cherty	4043
Lime	4073
Lime	4095
Lime	4114
Lime	4164
Lime	4201
Lime	4228
Lime	4268
Lime	4322
Lime	4335

T O P S

Douglas Sand	3555(-1969)
Brown Lime	3728(-2142)
Lansing	3738(-2152)
Miss. Ghat	4327(-2741)

PLUGGING
 FILE SEC 20 T. 31 R. 11W
 BOOK PAGE 143 LINE 28

GMR

File Copy

RECEIVED

STATE CORRELATION COMMISSION

MAR 17 1953
 3-13-53
 CONSERVATION DIVISION

The undersigned, Graham-Messman-Rinehart Oil Company, hereby certifies that the above log is a true and correct log of the formation encountered in drilling the above well as reflected by the Daily Drilling Reports.

Subscribed and sworn to before me
 this 5th day of April, 1953.

Barbara J. Scott Notary Public

GRAHAM-MESSMAN-RINEHART OIL COMPANY

By *J. A. Gilliland*
 J. A. Gilliland