

15-007-01557-0000

STATE OF KANSAS
STATE CORPORATION COMMISSION

WELL PLUGGING RECORD

OR
FORMATION PLUGGING RECORD

Strike out upper line
when reporting plug-
ging off formations.

Give All Information Completely
Make Required Affidavit
Mail or Deliver Report to:
Conservation Division
State Corporation Commission
800 Bittling Building
Wichita, Kansas

BARBER County. Sec. 19 Twp. 31S Rge. (E) 11 (W)

Location as "NE 1/4 NW 1/4 SW 1/4" or footage from lines. SE SW/4

Lease Owner. OLSON OIL COMPANY

Lease Name. M. T. Williams Well No. 1

Office Address. Drawer 588, Tulsa, Okla.

Character of Well (completed as Oil, Gas or Dry Hole) Dry Hole

Date, well completed. 5 - 19 - 19 41

Application for plugging filed. May 20 - 19 41

Application for plugging approved. 5 - 21 - 19 41


Plugging Commenced. 5 - 21 - 19 41

Plugging Completed. 5 - 23 - 19 41

Reason for abandonment of well or producing formation. Dry hole

If a producing well is abandoned, date of last production. 19

Was permission obtained from the Conservation Division or its agents before plugging was commenced? Yes

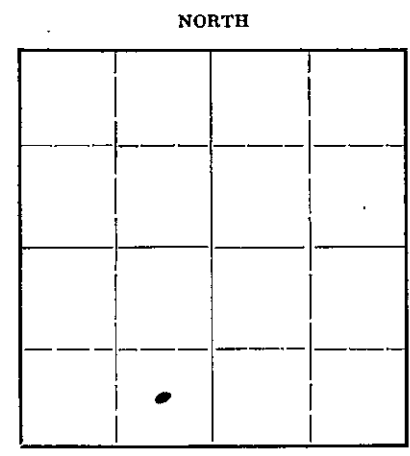

Locate well correctly on above
Section Plat

Name of Conservation Agent who supervised plugging of this well. C. T. Alexander

Producing formation. Chat Depth to top. 4317 Bottom. 4361 Total Depth of Well. 4361 Feet

Show depth and thickness of all water, oil and gas formations.


OIL, GAS OR WATER RECORDS

CASING RECORD

Formation	Content	From	To	Size	Put In	Pulled Out
Chat	Dry	4317	4361	8 5/8"	103	None
				5 1/2"	4312	2480 8"


Describe in detail the manner in which the well was plugged, indicating where the mud fluid was placed and the method or methods used in introducing it into the hole. If cement or other plugs were used, state the character of same and depth placed, from.....feet to.....feet for each plug set.

Hole filled with heavy mud from total depth to 4320, Bridged hole and filled with chat to 4308 and dumped 4 sacks of cement. Filled hole with heavy mud to 100 ft. Bridged and dumped 10 sacks of cement. Filled hole with mud and dumped 5 sacks of cement in casing at base of cellar.

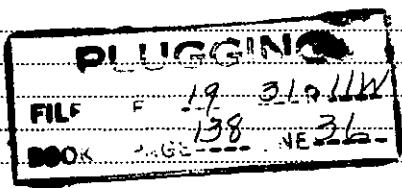

(If additional description is necessary, use BACK of this sheet)

Correspondence regarding this well should be addressed to. S. A. Keefover
Address. Box R, Burrton, Kansas

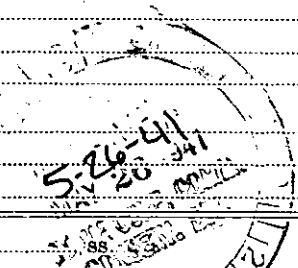

STATE OF KANSAS, COUNTY OF RENO
S. A. Keefover (employee of owner) or (owner) of the above-described well,

being first duly sworn on oath, says: That I have knowledge of the facts, statements, and matters herein contained and the log of the above-described well as filed and that the same are true and correct. So help me God.

(Signature) S. A. Keefover

(Address)

SUBSCRIBED AND SWORN to before me this 24th day of May, 19 41

My commission expires. 4/22/42

G. J. Bryant Notary Public.

OLSON OIL COMPANY
M. T. WILLIAMS # 1
SE SW/4, Sec. 19-31-11W
Barber County, Kansas

COMMENCED 4-27-41
COMPLETED 5-19-41
ELEVATION
INT. PROD. Dry hole

- 0
- 42 Clay & sand
- 102 Red rock
- 107 Anhydrite
- 491 Red rock & sand
- 1070 Red rock & shale
- 1190 Shale & shells
- 1535 Salt shale & shells
- 1600 Anhydrite & shale
- 2063 Lime & shale
- 2191 Lime
- 2526 Lime & shale
- 2754 Shale & lime shells
- 3130 Lime & shale
- 3190 Lime
- 3232 Shale, firm
- 3249 Lime
- 3338 Shale & shells 35
- 3500 Shale & lime shells
- 3530 Shale & lime
- 3567 Sand & shale
- 3583 Lime
- 3635 Sand
- 3660 Lime, broken
- 3704 Sand
- 3730 Lime
- 3761 Sand & lime
- 3863 Lime
- 3907 Sandy lime
- 3910 Lime
- 3950 Shale & lime
- 4040 Lime
- 4102 Lime & chert
- 4107 Lime
- 4120 Shale
- 4130 Lime
- 4135 Shale
- 4307 Shale & lime
- 4318 Shale
- 4321 Chat
- 4361 Chat, TOTAL DEPTH


SAND RECORD

TOP OF CHAT 4317
Light show of oil 4358

CASING RECORD

8 5/8" 32# 103
5 1/2" 15# S.S. 4312

PLUGGING
FILE # 19-31-11W
BOOK PAGE 128 LINE 36

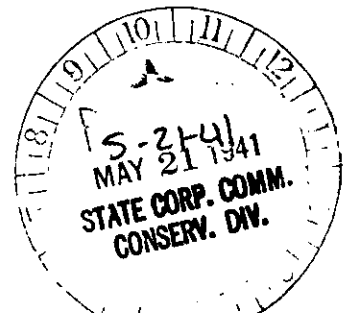

I hereby certify that the above is a true and correct copy of the log of M. T. Williams # 1, SE SW/4, Sec. 19-31S-11W, Barber Co., Kansas

Subscribed and sworn to before me this 21st Day of May, 1941

G. J. Bryant
Notary Public

S. A. Keefover