


15-007-00549-0000

STATE OF KANSAS
STATE CORPORATION COMMISSION

WELL PLUGGING RECORD

Give All Information Completely
Make Required Affidavit
Mail or Deliver Report to:
Conservation Division
State Corporation Commission
800 Bittling Building
Wichita, Kansas

NORTH

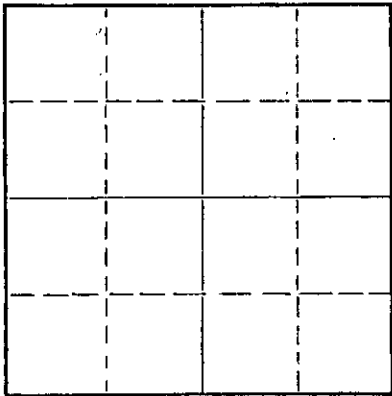

Locate well correctly on above
Section Plat

Barber County, Sec. 19 Twp. 31S Rge. 11 (X) W (W)
Location as "NE/CNWxSWx" or footage from lines SE NE NW
Lease Owner Rupp-Ferguson Oil Co.
Lease Name Catlin Well No. 1
Office Address 523 Petroleum Bldg., Wichita, Kansas
Character of Well (completed as Oil, Gas or Dry Hole) Dry Hole
Date well completed October 11, 19 54
Application for plugging filed October 11, 19 54
Application for plugging approved October 11, 19 54
Plugging commenced October 11, 19 54
Plugging completed October 11, 19 54
Reason for abandonment of well or producing formation

If a producing well is abandoned, date of last production 19
Was permission obtained from the Conservation Division or its agents before plugging was commenced? Yes

Name of Conservation Agent who supervised plugging of this well
Producing formation Depth to top Bottom Total Depth of Well 4730 Feet
Show depth and thickness of all water, oil and gas formations.

OIL, GAS OR WATER RECORDS

CASING RECORD

FORMATION	CONTENT	FROM	TO	SIZE	PUT IN	PULLED OUT
				8 5/8"	227'	None

Describe in detail the manner in which the well was plugged, indicating where the mud fluid was placed and the method or methods used in introducing it into the hole. If cement or other plugs were used, state the character of same and depth placed, from feet to feet for each plug set.

Filled hole with mud to 220'
Set plug at 220' with 20 sacks cement.
Filled hole to 35' with mud.
Set top plug at 35' with 10 sacks cement.

(If additional description is necessary, use BACK of this sheet)

Name of Plugging Contractor Rupp-Ferguson Oil Co.
Address 523 Petroleum Bldg., Wichita, Kansas

STATE OF KANSAS, COUNTY OF SEDGWICK, ss.
L. W. KNOX (employee of owner) of the above-described well, being first duly sworn on oath, says: That I have knowledge of the facts, statements, and matters herein contained and the log of the above-described well as filed and that the same are true and correct. So help me God.

(Signature) L.P. Enoff
Landman - Rupp-Ferguson Oil Co.
523 Petroleum Bldg., Wichita, Kansas
(Address)

SUBSCRIBED AND SWORN TO before me this 19th day of October, 1954

Katherine E. Allan
Notary Public.

My commission expires January 16, 1957

PLUGGING
FILE SEC 19 T 31 R 11 W
BOOK PAGE 71 LINE 2

RECEIVED
COMMISSION
10-20-54

CONTRACTOR'S WELL LOG

COMPANY	Rupp-Ferguson Oil Co.
CONTRACTOR	Rupp-Ferguson Oil Co.
FARM	Catlin #1
LOCATION	SE NE NW Section 19-31S-11W Barber County, Kansas
COMMENCED	September 26, 1954
COMPLETED	October 14, 1954

0	65	Sand & gravel
65	228	Red rock, red bed & shale
228	345	Red bed
345	1180	Shale & shells
1180	1300	Salt & shale
1300	1525	Shale & shells
1525	2612	Lime & shale
2612	2653	Sand
2653	3483	Lime & shale
3483	3484	Sand
3484	3780	Sand, lime & shale
3780	3886	Lime
3886	3933	Lime & shale
3933	4043	Lime
4043	4320	Lime & shale
4320	4326	Chert
4326	4345	Mississippi
4345	4374	Lime & chert
4374	4428	Lime, shale & chert
4428	4570	Shale
4570	4644	Shale, lime & chert
4644	4674	Chert & lime
4674	4730	Chert, lime & sand
	4730	Rotary Total Depth

Set 8-5/8" surface casing at 227' with 150 sacks cement, 2 C.C.

Dry & Abandoned

STATE OF KANSAS)
) SS
COUNTY OF SEDGWICK)


I, L. W. KNOX, Landman with Rupp-Ferguson Oil Co., do hereby certify that the above and foregoing is a true and correct copy of the log of the Catlin #1, SE NE NW Section 19-31S-11W, Barber County, Kansas, as reflected by the files of Rupp-Ferguson Oil Co.

L. W. Knox

Subscribed and sworn to before me, a Notary Public, in and for Sedgwick County, Kansas, this 19th day of October, 1954.

Katherine E. Allan

My commission expires January 16, 1957.

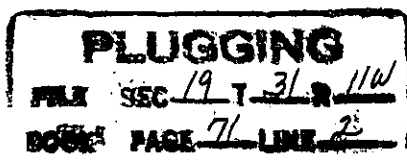

STATE
OCT 20 1954
CONCE