

Must be approved by the K.C.C. five (5) days prior to commencing well

Expected Spud Date August 6, 1989
month day year

* C. SW. NW. Sec 11 Twp 33 S, Rg 14 X East West

OPERATOR: License # 03532
Name: CMX, Inc.
Address: 1026 Union Center Building
City/State/Zip: Wichita, Kansas 67202
Contact Person: Doug McGinness II
Phone: (316) 269-9052

..... 3300 feet from South line of Section
* ~~41620-1988~~ feet from East line of Section
(Note: Locate well on Section Plat Below)

CONTRACTOR: License #: 5929
Name: Duke Drilling Co., Inc.

County: Barber
Lease Name: Angell Well #: 6
Field Name: UNKNOWN
Is this a Prorated field? yes no
Target Formation(s): VIOLA
Nearest lease or unit boundary: 660'
Ground Surface Elevation: UNKNOWN feet MSL
Domestic well within 330 feet: yes no
Municipal well within one mile: yes no
Depth to bottom of fresh water: 125'
Depth to bottom of usable water: 180'
Surface Pipe by Alternate: 1 2
Length of Surface Pipe Planned to be set: 360'
Length of Conductor pipe required: None
Projected Total Depth: 5100'
Formation at Total Depth: Ordovician
Water Source for Drilling Operations:
Unknown well farm pond other
DWR Permit #:
Will Cores Be Taken?: yes no
If yes, proposed zone:

Well Drilled For: Well Class: Type Equipment:

Oil ... Inj ... Infield Mud Rotary
 Gas ... Storage ... Pool Ext. ... Air Rotary
... OAWD ... Disposal Wildcat ... Cable
... Seismic; ... # of Holes

If OAWD: old well information as follows:

Operator:
Well Name:
Comp. Date: Old Total Depth

Directional, Deviated or Horizontal wellbore? yes no

If yes, total depth location:

* WAS: C-SW-NE; 1980' FEL

AFFIDAVIT


The undersigned hereby affirms that the drilling, completion and eventual plugging of this well will comply with K.S.A. 55-101, et. seq.

It is agreed that the following minimum requirements will be met:

1. The appropriate district office shall be notified before setting surface pipe;
2. The minimum amount of surface pipe as specified above shall be set by circulating cement to the top; in all cases surface pipe shall be set through all unconsolidated materials plus a minimum of 20 feet into the underlying formation;
3. If the well is dry, a plugging proposal shall be submitted to the district office. An agreement between the operator and the district office on plug length and placement is necessary prior to plugging;
4. The appropriate district office will be notified before well is either plugged or production casing is cemented in;
5. If an Alternate II completion, production pipe shall be cemented from below any usable water to surface within 120 days of spud date. In all cases, notify district office prior to any cementing.

I hereby certify that the statements made herein are true and to the best of my knowledge and belief.

Date: 7-13-89 Signature of Operator or Agent: *[Signature]* Title: President

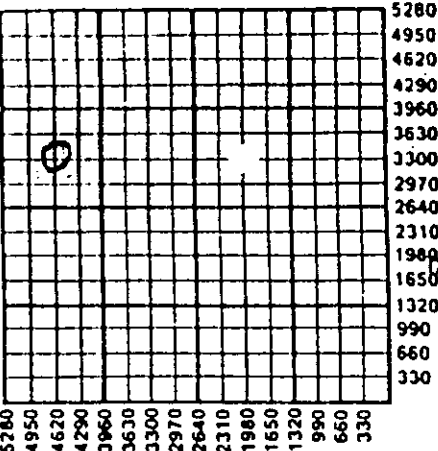

STATE CORPORATION COMMISSION

7-21-89
JUL 21 1989

MAILED
JUL 19 1989
7-19-89
CONSERVATION DIVISION
Wichita, Kansas

FOR KCC USE:
COP # 15-007-22,247-0000
Conductor pipe required NONE feet
Minimum surface pipe required 200' feet per Alt.
Approved by: DPW 7-18-89; DPW 7-24-89
EFFECTIVE DATE: 7-23-89
This authorization expires: 7-18-90
(This authorization void if drilling not started within 6 months of effective date.)
Spud date: _____ Agent: _____

33
14w

REMEMBER TO:

- File Drill Pit Application (form COP-1) with Intent to Drill;
- File Completion Form ACO-1 within 120 days of spud date;
- File acreage attribution plat according to field proration orders;
- Notify appropriate district office 48 hours prior to workover or re-entry;
- Submit plugging report (CP-4) after plugging is completed;
- Obtain written approval before disposing or injecting salt water.