

NOTICE OF INTENTION TO DRILL

(see rules on reverse side)

Expected Spud Date..... May 23, 1988
month day yearOPERATOR: License #..... 8887
Name..... KACHINA OIL COMPANY, INC.
Address..... 200 West Douglas - Suite 510
City/State/Zip..... Wichita, Kansas 67202
Contact Person..... Chas Sanders
Phone..... 316/262-2531CONTRACTOR: License #..... 5929
Name..... DUKE DRILLING CO., INC.
City/State..... Great Bend, Kansas 67530Well Drilled For: Well Class: Type Equipment:
 Oil Storage Infield Mud Rotary
 Gas Inj Pool Ext. Air Rotary
 OWWO Expl Wildcat Cable

If OWWO: old well info as follows:

Operator.....
Well Name.....
Comp Date..... Old Total Depth.....

I certify that well will comply with K.S.A. 55-101, et seq., plus eventually plugging hole to KCC specifications.

Date May 21, 1988 Signature of Operator or Agent Sally R. Byers Title Agent
Sally R. Byers

For KCC Use:

Conductor Pipe Required..... feet; Minimum Surface Pipe Required..... 200 feet per Alt. X
This Authorization Expires 11-20-88 Approved By DA 5-20-88EFFECTIVE DATE: 5-25-88API Number 15- 007-22,189-0000
E/2
8 W/2 SE Sec. 2 Twp. 33 S. Rg. 14 East
 West
1320 Ft. from South Line of Section
1980 1650 Ft. from East Line of Section
(Note: Locate well on Section Plat on reverse side)Nearest lease or unit boundary line..... 660 feet
County..... BarberLease Name..... angell Well #..... 4
Ground surface elevation..... feet MSL
Domestic well within 330 feet: yes no
Municipal well within one mile: yes noDepth to bottom of fresh water..... 100
Depth to bottom of usable water..... 180
Surface pipe by Alternate: 1 2
Surface pipe planned to be set..... 200
Conductor pipe required.....
Projected Total Depth..... 5000 feet
Formation..... Viola


✓

Must be filed with the K.C.C. five (5) days prior to commencing well
This card void if drilling not started within six (6) months of date received by K.C.C.

Important procedures to follow:

1. Notify District office before setting surface casing.
2. Set surface casing by circulating cement to the top.
3. File completion forms ACO-1 with K.C.C. within 120 days of well spud date, following instructions on ACO-1, side 1, and including copies of wireline logs.
4. Notify District office 48 hours prior to old well workover or re-entry.
5. Prior to filing Intent, prepare a proposed plugging plan in case well is D & A, then obtain approval of plan when calling district office prior to setting surface pipe.
6. Submit plugging report (CP-4) to K.C.C. after plugging is completed.
7. Obtain an approved injection docket number before disposing of salt water.
8. Notify K.C.C. within 10 days when injection commences or terminates.

**A Regular Section of Land
1 Mile = 5,280 Ft.**

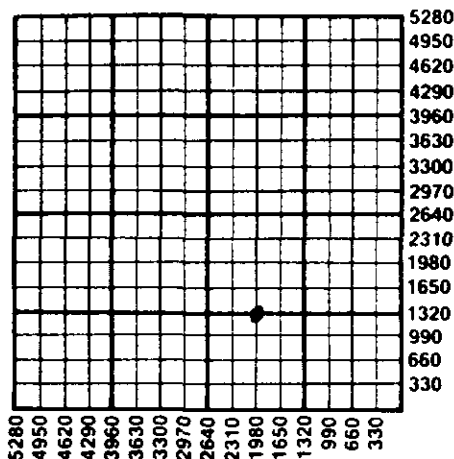

RECEIVED
STATE CORPORATION COMMISSION

MAY 20 1988
5-20-88
CONSERVATION DIVISION
Wichita, Kansas

alternate 2 completion, cement in the production pipe from below any usable water to surface within 120 days of spud date.

State Corporation Commission of Kansas
Conservation Division
200 Colorado Derby Building
Wichita, Kansas 67202-1212
(316) 263-3238