

CARD MUST BE TYPED

State of Kansas  
**NOTICE OF INTENTION TO DRILL**  
(see rules on reverse side)

CARD MUST BE SIGNED

Starting Date: August 19, 1985  
month day year

API Number 15- 007-22,075-0000

OPERATOR: License # 7077  
Name Eowen Oil & Exploration, Inc.  
Address 720 N. Main #320  
City/State/Zip Hutchinson, Kansas 67502  
Contact Person Ralph G. Bowen  
Phone 316-665-6563

SE Quarter Sec 2... Twp. 33. S, Rge. 14.  
(location)  East  West  
510 Ft North from Southeast Corner of Section  
740 Ft West from Southeast Corner of Section  
(Note: Locate well on Section Plat on reverse side)

CONTRACTOR: License # 5149  
Name Wheatstate Drilling  
City/State Pratt, Kansas

Nearest lease or unit boundary line ~~XXXX~~ 510 feet.  
County Barber  
Lease Name Elmer Angell Well# 3

Well Drilled For: Well Class: Type Equipment:  
 Oil  Swd  Infield  Mud Rotary  
 Gas  Inj  Pool Ext.  Air Rotary  
 OWWO  Expl  Wildcat  Cable

Domestic well within 330 feet:  yes  no  
Municipal well within one mile:  yes  no

If OWWO: old well info as follows:  
Operator  
Well Name  
Comp Date Old Total Depth  
Projected Total Depth 5000 feet  
Projected Formation at TD Viola  
Expected Producing Formations Lansing, Mississippi & Viola

Depth to Bottom of fresh water ~ 100 feet  
Lowest usable water formation Missnewalla Group  
Depth to Bottom of usable water 200 feet  
Surface pipe by Alternate: 1  2   
Surface pipe to be set 300 feet  
Conductor pipe if any required feet  
Ground surface elevation 1854 gr feet MSI.  
This Authorization Expires 2-20-86  
Approved By RCH 8-20-85

I certify that we will comply with K.S.A. 55-101, et seq., plus eventually plugging hole to K.C.C. specifications.


Date 8-19-85 Signature of Operator or Agent *Ralph G. Bowen* Title *Sus*

Must be filed with the K.C.C. five (5) days prior to commencing well  
 This card void if drilling not started within six (6) months of date received by K.C.C.

RECEIVED  
 STATE CORPORATION COMMISSION  
 AUG 20 1985  
 8-20-85  
 CONSERVATION DIVISION  
 Wichita, Kansas

**Important procedures to follow:**

**A Regular Section of Land  
 1 Mile = 5,280 Ft.**

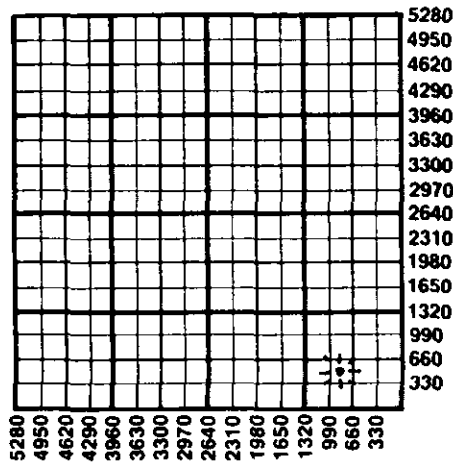

1. Notify District office before setting surface casing.
2. Notify District office before setting surface casing by circulating cement to the top.
3. File completion forms ACO-1 with K.C.C. within 90 days of well completion, following instructions on ACO-1, side I, and including copies of wireline logs.
4. Notify District office 48 hours prior to old well workover or re-entry.
5. Prior to plugging, prepare a plugging plan, then obtain agreement from the appropriate district office for an approved plugging plan.
6. Submit plugging report (CP-4) to K.C.C. after plugging is completed.
7. Obtain an approved injection docket number before disposing of salt water.
8. Notify K.C.C. within 10 days when injection commences or terminates.
9. If an alternate 2 completion, cement in the production pipe from below any usable water to surface within 120 days of spud date.

**State Corporation Commission of Kansas  
 Conservation Division  
 200 Colorado Derby Building  
 Wichita, Kansas 67202  
 (316) 263-3238**