

CARD MUST BE TYPED

State of Kansas
NOTICE OF INTENTION TO DRILL

CARD MUST BE SIGNED

(see rules on reverse side)

Starting Date: March 18 85
month day year

API Number 15- 077-21,082-00-00

OPERATOR: License # 5673
Name W. L. Kirkman, Inc.
Address P.O. Box 18611
City/State/Zip Wichita, Kansas 67128
Contact Person Wayne L. Kirkman
Phone 316/685-5372

NW NW Sec 11 Twp 32 S, Rge 7
(location) East West

4620' Ft North from Southeast Corner of Section
4620' Ft West from Southeast Corner of Section
(Note: Locate well on Section Plat on reverse side)

CONTRACTOR: License # 5928
Name Aldebaran Drilling Co., Inc.
City/State Wichita, Kansas

Nearest lease or unit boundary line 660 feet.
County Harper
Lease Name Parsons Well# 1-11

Well Drilled For: Well Class: Type Equipment:
 Oil Swd Infield Mud Rotary
 Gas Inj Pool Ext. Air Rotary
 OWWO Expl Wildcat Cable

Domestic well within 330 feet: yes no
Municipal well within one mile: yes no

If OWWO: old well info as follows:

Operator
Well Name
Comp Date Old Total Depth
Projected Total Depth 4800' feet
Projected Formation at TD Simpson
Expected Producing Formations

Depth to Bottom of fresh water 70 feet
Lowest usable water formation Harper Sandstone
Depth to Bottom of usable water 200 feet
Surface pipe by Alternate: 1 2
Surface pipe to be set 280 feet
Conductor pipe if any required none feet
Ground surface elevation 1425' feet MSL
This Authorization Expires 9-13-85
Approved By 3-13-85 *Re*

I certify that we will comply with K.S.A. 55-101, et seq., plus eventually plugging hole to K.C.C. specifications.

Date March 13, 1985
Signature of Operator or Agent

Wayne L. Kirkman
Wayne L. Kirkman

Title President

Form C-1 4/84


MHC MOHE 3-13-85

Must be filed with the K.C.C. five (5) days prior to commencing well
This card void if drilling not started within six (6) months of date received by K.C.C.

CONSERVATION DIVISION
Wichita, Kansas

MAR 13 1985

RECEIVED
STATE CORPORATION COMMISSION
A Regular Section of Land

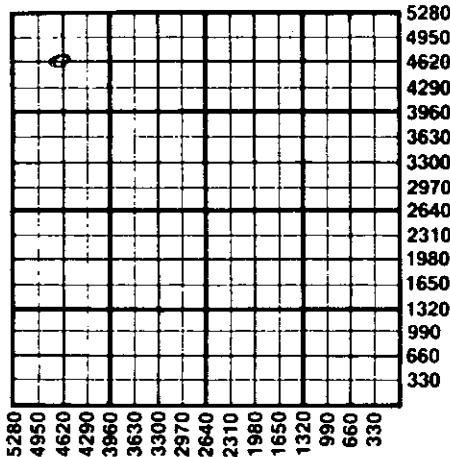

Important procedures to follow :

1. Notify District office before setting surface casing.
2. Set surface casing by circulating cement to the top.
3. File completion forms ACO-1 with K.C.C. within 90 days of well completion, following instructions on ACO-1, side 1, and including copies of wireline logs.
4. Notify District office 48 hours prior to old well workover or re-entry.
5. Prior to plugging, prepare a plugging plan, then obtain agreement from the appropriate district office for an approved plugging plan.
6. Submit plugging report (CP-4) to K.C.C. after plugging is completed.
7. Obtain an approved injection docket number before disposing of salt water.
8. Notify K.C.C. within 10 days when injection commences or terminates.
9. If an alternate 2 completion, cement in the production pipe from below any usable water to surface within 120 days of spud date.

State Corporation Commission of Kansas
Conservation Division
200 Colorado Derby Building
Wichita, Kansas 67202
(316) 263-3238