

CARD MUST BE TYPED

State of Kansas

CARD MUST BE SIGNED

# NOTICE OF INTENTION TO DRILL

(see rules on reverse side)

Expected Spud Date.....  
month day year

API Number 15- 077-01,006-00-01

OPERATOR: License # 5171

SW SW SE Sec. 2 Twp 32S S, Rg 7 XX West

Name TXO Production Corp.

330' Ft. from South Line of Section

Address 155 N Market Suite 1000

2310' FEL Ft. from East Line of Section

City/State/Zip Wichita, Kansas 67202

(Note: Locate well on Section Plat on reverse side)

Contact Person Jeffrey S. Childs

Nearest lease or unit boundary line 330' feet

Phone (316) 269-7662

County Harper

CONTRACTOR: License # 5418

Lease Name WILLIAMS "QQ" (OWWO) Well # 1

Name Allen Drilling

Ground surface elevation ..... feet MSL

City/State Great Bend, KS. 67530

Domestic well within 330 feet: —yes X no

Well Drilled For: Well Class: Type Equipment:

Municipal well within one mile: —yes X no

— Oil — Storage — Infield X Mud Rotary

Depth to bottom of fresh water: 100'

X Gas — Inj — Pool Ext. — Air Rotary

Depth to bottom of usable water: 225'

X OWWO — Expl — Wildcat — Cable

Surface pipe by Alternate: 1 X X

If OWWO: old well info as follows:

Surface pipe ~~planned to be set~~ 240'

Operator Arvel Smith, et.al.

Conductor pipe required none

Well Name Williams #1

Projected Total Depth 3700' feet

Comp Date 12-13-60 Old Total Depth 4776'

Formation Stalnaker S S

I certify that well will comply with K.S.A. 55-101, et seq., plus eventually plugging hole to KCC specifications.

Date July 10, 1987 Signature of Operator or Agent Jeffrey S. Childs

Title Drlg. & Prod. Engineer

For KCC Use:

001 1-3-1987

Conductor Pipe Required ..... feet; Minimum Surface Pipe Required 240 feet per Alt. 1 X

This Authorization Expires 1-13-88 Approved By 7-13-87


CONSERVATION DIVISION  
Wichita, Kansas

Must be filed with the K.C.C. five (5) days prior to commencing well  
This card void if drilling not started within six (6) months of date received by K.C.C.

**Important procedures to follow:**

1. Notify District office before setting surface casing.
2. Set surface casing by circulating cement to the top.
3. File completion forms ACO-1 with K.C.C. within 120 days of well spud date, following instructions on ACO-1, side 1, and including copies of wireline logs.
4. Notify District office 48 hours prior to old well workover or re-entry.
5. Prior to filing Intent, prepare a proposed plugging plan in case well is D & A, then obtain approval of plan when calling district office prior to setting surface pipe.
6. Submit plugging report (CP-4) to K.C.C. after plugging is completed.
7. Obtain an approved injection docket number before disposing of salt water.
8. Notify K.C.C. within 10 days when injection commences or terminates.
9. If an alternate 2 completion, cement in the production pipe from below any usable water to surface within 120 days of spud date.

**A Regular Section of Land**  
1 Mile = 5,280 Ft.

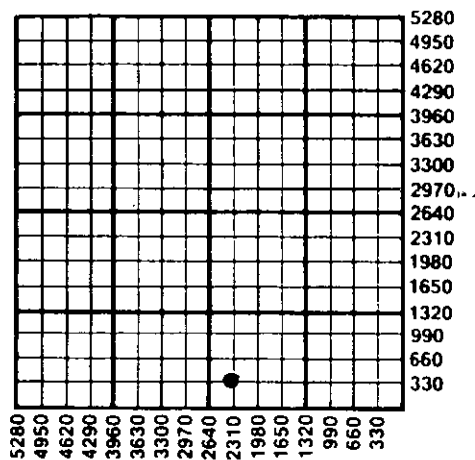

State Corporation Commission of Kansas  
Conservation Division  
200 Colorado Derby Building  
Wichita, Kansas 67202-1212  
(316) 263-3238