

CARD MUST BE TYPED

State of Kansas
NOTICE OF INTENTION TO DRILL
(see rules on reverse side)

CARD MUST BE SIGNED

Starting Date: 6 15 1985
month day year

API Number 15- 007-22,055-0000

OPERATOR: License # 6006
Name Molz Oil Company
Address R.R. 2, Box 54
City/State/Zip Kiowa, Kansas 67070
Contact Person Jim Molz
Phone 316-296-4558

M.C. SW SW/4 ... Sec 25. Twp 34 S, Rge 12. East West
(location)

915
4730 Ft North from Southeast Corner of Section
Ft West from Southeast Corner of Section
(Note: Locate well on Section Plat on reverse side)

CONTRACTOR: License # 5658
Name Sweetman Drilling, Inc.
City/State Wichita, Kansas 67202

Nearest lease or unit boundary line 550 feet.
County Barber
Lease Name Hickles Well# 3
Domestic well within 330 feet: yes no
Municipal well within one mile: yes no

Well Drilled For: Well Class: Type Equipment:
 Oil Swd Infield Mud Rotary
 Gas Inj Pool Ext. Air Rotary
 OWWO Expl Wildcat Cable

Depth to Bottom of fresh water 150 feet
Lowest usable water formation Permian
Depth to Bottom of usable water 200 feet
Surface pipe by Alternate: 1, 2
Surface pipe to be set 240', 10 3/4" feet
Conductor pipe if any required none feet
Ground surface elevation 1383 feet MSL.
This Authorization Expires 12-10-85
Approved By 6-10-85 [Signature]

If OWWO: old well info as follows:

Operator
Well Name
Comp Date Old Total Depth
Projected Total Depth 4900 feet
Projected Formation at TD Mississippi
Expected Producing Formations Mississippi

I certify that we will comply with K.S.A. 55-101, et seq., plus eventually plugging hole to K.C.C. specifications.

Date 6-7-85 Signature of Operator or Agent [Signature]


Title [Signature]

MHC/UNHE 6-10-85

Must be filed with the K.C.C. five (5) days prior to commencing well
This card void if drilling not started within six (6) months of date received by K.C.C.

A Regular Section of Land
1 Mile = 5,280 Ft.

RECEIVED
STATE CORPORATION COMMISSION
JUN 17 1985
6-10-85
CONSERVATION DIVISION
Wichita, Kansas

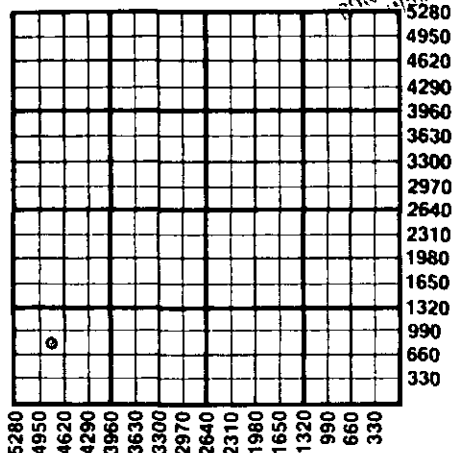

Important procedures to follow :

1. Notify District office before setting surface casing.
2. Set surface casing by circulating cement to the top.
3. File completion forms ACO-1 with K.C.C. within 90 days of well completion, following instructions on ACO-1, side 1, and including copies of wireline logs.
4. Notify District office 48 hours prior to old well workover or re-entry.
5. Prior to plugging, prepare a plugging plan, then obtain agreement from the appropriate district office for an approved plugging plan.
6. Submit plugging report (CP-4) to K.C.C. after plugging is completed.
7. Obtain an approved injection docket number before disposing of salt water.
8. Notify K.C.C. within 10 days when injection commences or terminates.
9. If an alternate 2 completion, cement in the production pipe from below any usable water to surface within 120 days of spud date.

State Corporation Commission of Kansas
Conservation Division
200 Colorado Derby Building
Wichita, Kansas 67202
(316) 263-3238