

CARD MUST BE TYPED

State of Kansas
NOTICE OF INTENTION TO DRILL

CARD MUST BE SIGNED

(see rules on reverse side)

Starting Date: July 1, 1984
month day year

API Number 15- 007-21,864-0000
SE NE NE Sec 35 Twp 34 S, Rge 12 East
(location) West

OPERATOR: License # 5042
Name Edmiston Oil Company, Inc.
Address 1260 KSB Bldg.
City/State/Zip Wichita, Kansas 67202
Contact Person Jon M. Callen
Phone 265-5241

4290
330
Ft North from Southeast Corner of Section
Ft West from Southeast Corner of Section
(Note: Locate well on Section Plat on reverse side)

CONTRACTOR: License # 5107
Name H-30, Inc.
City/State Wichita, Kansas

Nearest lease or unit boundary line 330 feet.
County Barber
Lease Name Morton 'B' Well# 4

Well Drilled For: Well Class: Type Equipment:
 Oil Swd Infield Mud Rotary
 Gas Inj Pool Ext. Air Rotary
 OWWO Expl Wildcat Cable

Domestic well within 330 feet: yes no
Municipal well within one mile: yes no

If OWWO: old well info as follows:
Operator
Well Name
Comp Date Old Total Depth
Projected Total Depth 4900 feet
Projected Formation at TD Mississippi
Expected Producing Formations Mississippi

Depth to Bottom of fresh water 128 feet
Lowest usable water formation Nippewalla
Depth to Bottom of usable water 200 feet
Surface pipe by Alternate: 1 2
Surface pipe to be set 750' feet
Conductor pipe if any required None feet
Ground surface elevation 1406 feet MSI
This Authorization Expires 2-27-84
Approved By 6-27-84

I certify that we will comply with K.S.A. 55-101, et seq., plus eventually plugging hole to K.C.C. specifications.

Date 6-27-84 Signature of Operator or Agent Jon M. Callen Title Vice-Pres. Operations


Jon M. Callen

MHC/NOHE 6-27-84

Must be filed with the K.C.C. five (5) days prior to commencing well
This card void if drilling not started within six (6) months of date received by K.C.C.

Important procedures to follow :

**A Regular Section of Land
1 Mile = 5,280 Ft.**

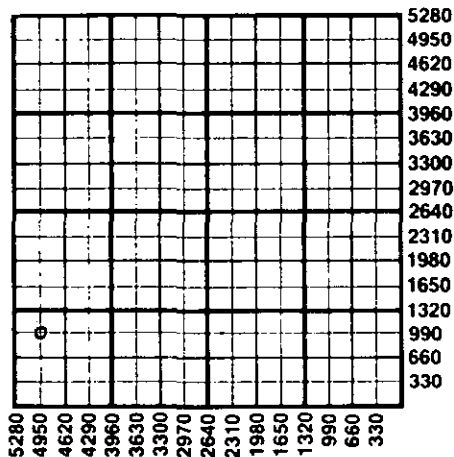

1. Notify District office before setting surface casing.
2. Set surface casing by circulating cement to the top.
3. File completion forms ACO-1 with K.C.C. within 90 days of well completion, following instructions on ACO-1, side 1, and including copies of wireline logs.
4. Notify District office 48 hours prior to old well workover or re-entry.
5. Prior to plugging, prepare a plugging plan, then obtain agreement from the appropriate district office for an approved plugging plan.
6. Submit plugging report (CP-4) to K.C.C. after plugging is completed.
7. Obtain an approved injection docket number before disposing of salt water.
8. Notify K.C.C. within 10 days when injection commences or terminates.
9. If an alternate 2 completion, cement in the production pipe from below any usable water to surface within 120 days of spud date.

State Corporation Commission of Kansas
Conservation Division
200 Colorado Derby Building
Wichita, Kansas 67202
(316) 263-3238