

CARD MUST BE TYPED

State of Kansas
NOTICE OF INTENTION TO DRILL
(see rules on reverse side)

CARD MUST BE SIGNED

Starting Date: September 10, 1984
month day year

API Number 15- 007-21,912-0000

OPERATOR: License # 5601
Name Associated Petroleum Consultants, Inc.
Address Suite 600 - One Main Place
City/State/Zip Wichita, Kansas 67202-1399
Contact Person Paul C. Caragianis
Phone (316) 265-9385

C NW NE Sec 36 Twp 34 S, Rge 12 East
(location) West
4620 Ft North from Southeast Corner of Section
1980 Ft West from Southeast Corner of Section
(Note: Locate well on Section Plat on reverse side)

CONTRACTOR: License # 5867
Name Heartland Drilling, Inc.
City/State Wichita, Kansas 67202-1399

Nearest lease or unit boundary line 660 feet.
County Barber
Lease Name Wetz Well# 3
Domestic well within 330 feet: yes no
Municipal well within one mile: yes no

Well Drilled For: Well Class: Type Equipment:
 Oil Swd Infield Mud Rotary
 Gas Inj Pool Ext. Air Rotary
 OWWO Expl Wildcat Cable

Depth to Bottom of fresh water 50' feet
Lowest usable water formation Unconsolidated
Depth to Bottom of usable water 200' feet
Surface pipe by Alternate: 1 2
Surface pipe to be set 200' feet
Conductor pipe if any required 200'+ 10. 3/4" feet
Ground surface elevation 1390' feet MSI.
This Authorization Expires 2-28-85
Approved By 8-22-84 PC

If OWWO: old well info as follows:

Operator
Well Name
Comp Date Old Total Depth
Projected Total Depth 4750' feet
Projected Formation at TD Mississippian
Expected Producing Formations Mississippian

I certify that we will comply with K.S.A. 55-101, et seq., plus eventually plugging hole to K.C.C. specifications.

Date 8/27/84 Signature of Operator or Agent


PC Title Geologist
PAUL C. CARAGIANIS

MHC/WONE STARRY

Must be filed with the K.C.C. five (5) days prior to commencing well
 This card void if drilling not started within six (6) months of date received by K.C.C.

Important procedures to follow :

A Regular Section of Land
1 Mile = 5,280 Ft.

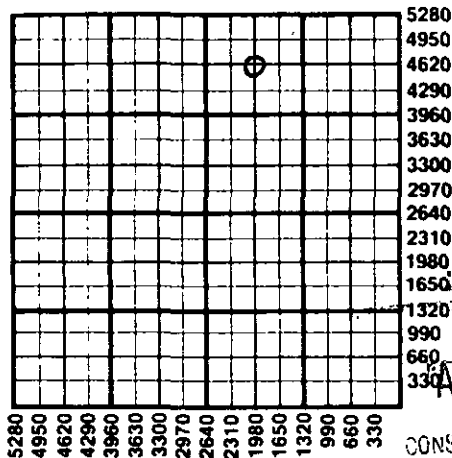

1. Notify District office before setting surface casing.
 2. Set surface casing by circulating cement to the top.
 3. File completion forms ACO-1 with K.C.C. within 90 days of well completion, following instructions on ACO-1, side 1, and including copies of wireline logs.
 4. Notify District office 48 hours prior to old well workover or re-entry.
 5. Prior to plugging, prepare a plugging plan, then obtain agreement from the appropriate district office for an approved plugging plan.
 6. Submit plugging report (CP-4) to K.C.C. after plugging is completed.
 7. Obtain an approved injection docket number before disposing of salt water.
 8. Notify K.C.C. within 10 days when injection commences or terminates.
9. Plan an alternate 2 completion, cement in the production pipe from below any usable water to surface within 120 days of spud date.

RECEIVED
 CONSERVATION COMMISSION
 AUG 28 1984
 8-28-84
 CONSERVATION DIVISION
 Wichita, Kansas

State Corporation Commission of Kansas
Conservation Division
200 Colorado Derby Building
Wichita, Kansas 67202
(316) 263-3238