

CARD MUST BE TYPED



State of Kansas

CARD MUST BE SIGNED

# NOTICE OF INTENTION TO DRILL

(see rules on reverse side)

Starting Date ..... December 1, 1986  
month day year

API Number 15- 007-01,016-00-01

OPERATOR: License # 6006  
Name Molz Oil Company  
Address R.R. #2, Box 54  
City/State/Zip Kiowa, Kansas 67070  
Contact Person Jim Molz  
Phone 316-296-4558

NW NW NW Sec. 13 Twp. 34 S, Rg. 12 East  
4950 Ft. from South Line of Section  
4950 Ft. from East Line of Section

(Note: Locate well on Section Plat on reverse side)

CONTRACTOR: License # 5418  
Name Allen Drilling Co.  
City/State Great Bend, KS.

Nearest lease or unit boundary line 330 feet  
County Barber  
Lease Name Harbaugh Well # 2

Well Drilled For: Well Class: Type Equipment:  
 Oil  SWD  Infield  Mud Rotary  
 Gas  Inj  Pool Ext.  Air Rotary  
 OWWO  Expl  Wildcat  Cable

Ground surface elevation 1446 feet MSL  
Domestic well within 330 feet:  yes  no  
Municipal well within one mile:  yes  no

If OWWO: old well info as follows:  
Operator Flynn Oil Company  
Well Name Humphrey #1  
Comp Date 1-28-49 Old Total Depth 5337

Depth to bottom of fresh water 150  
Depth to bottom of usable water 200  
Surface pipe by Alternate: OWWO 1 X 2  
Surface pipe ~~planned~~ set 10 3/4 - 415' w/ 250sx  
Conductor pipe required none  
Projected Total Depth 5337 feet  
Formation Mississippi

I certify that well will comply with K.S.A. 55-101, et seq., plus eventually plugging hole to KCC specifications.  
Date 11-26-86 Signature of Operator or Agent Title President


For KCC Use:  
Conductor Pipe Required ..... feet; Minimum Surface Pipe Required 7/15 feet per Alt.   
This Authorization Expires 6-1-87 Approved By 12-1-86

Must be filed with the K.C.C. five (5) days prior to commencing well  
This card void if drilling not started within six (6) months of date received by K.C.C.

### Important procedures to follow:

1. Notify District office before setting surface casing.
2. Set surface casing by circulating cement to the top.
3. File completion forms ACO-1 with K.C.C. within 90 days of well completion, following instructions on ACO-1, side 1, and including copies of wireline logs.
4. Notify District office 48 hours prior to old well workover or re-entry.
5. Prior to filing Intent, prepare a proposed plugging plan in case well is D & A, then obtain approval of plan when calling district office prior to setting surface pipe.
6. Submit plugging report (CP-4) to K.C.C. after plugging is completed.
7. Obtain an approved injection docket number before disposing of salt water.
8. Notify K.C.C. within 10 days when injection commences or terminates.
9. If an alternate 2 completion, cement in the production pipe from below any usable water to surface within 120 days of spud date.

### A Regular Section of Land 1 Mile = 5,280 Ft.

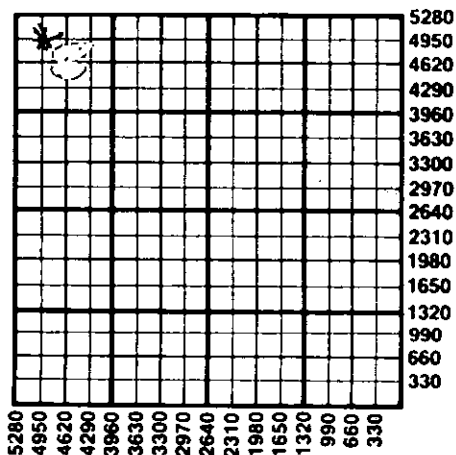

DEC 1 1986  
RZ-186

DEC 5 1986

State Corporation Commission of Kansas  
Conservation Division  
200 Colorado Derby Building  
Wichita, Kansas 67202  
(316) 263-3238