

CARD MUST BE TYPED

State of Kansas
NOTICE OF INTENTION TO DRILL
 (see rules on reverse side)

CARD MUST BE SIGNED

Starting Date: 11 4 84
 month day year

API Number 15- 077-21,048-~~00-00~~ CORRECTION

OPERATOR: License # 5123
 Name Pickrell Drilling Company
 Address 110 N. Market, Suite 205
 City/State/Zip Wichita, Kansas 67202
 Contact Person Jay McNeil
 Phone (316) 262-8427

* C E/2. SE NE ... Sec. 17, Twp 31... S, Rge. 9... East
 (location) West

..... 3300 Ft North from Southeast Corner of Section
 330 Ft West from Southeast Corner of Section
 (Note: Locate well on Section Plat on reverse side)

CONTRACTOR: License # 5123
 Name Pickrell Drilling Company
 City/State Wichita, Kansas

Nearest lease or unit boundary line 330 feet.

County Harper

Lease Name Anthony "B" Well# 1

Domestic well within 330 feet : yes no

Municipal well within one mile : yes no

Well Drilled For: Well Class: Type Equipment:
 Oil Swd Infield Mud Rotary
 Gas Inj Pool Ext. Air Rotary
 OWWO Expl Wildcat Cable

Depth to Bottom of fresh water 145 feet

Lowest usable water formation Harper Siltstone

Depth to Bottom of usable water 200 feet

Surface pipe by Alternate : 1 2

Surface pipe to be set 200+ feet

Conductor pipe if any required feet

Ground surface elevation feet MSL

This Authorization Expires 4-30-85

Approved By 11-6-84 Orig. Rec'd 10-30-84

If OWWO: old well info as follows:

Operator

Well Name

Comp Date Old Total Depth

Projected Total Depth 4550 feet

Projected Formation at TD Mississippian

Expected Producing Formations Mississippian

I certify that we will comply with K.S.A. 55-101, et seq., plus eventually plugging hole to K.C.C. specifications.

Date 11-5-84 Signature of Operator or Agent

Title Jay McNeil - Chief Geologist


*NOTE: Location moved 330' east of original. WAS: C SE-NE 3300 FSL Form C-1 4/84
 660 FSL

RECEIVED
STATE CORPORATION COMMISSION

Must be filed with the K.C.C. five (5) days prior to commencing well
This card void if drilling not started within six (6) months of date received by K.C.C.

NOV 06 '45

CONSERVATION DIVISION
A Regular Section of Land
1 Mile \approx 5,280 Ft.
Wichita, Kansas

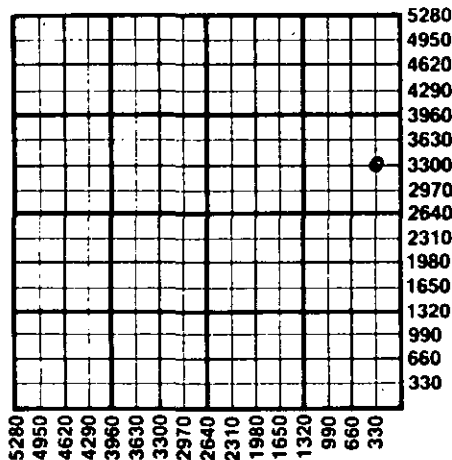

Important procedures to follow:

1. Notify District office before setting surface casing.
2. Set surface casing by circulating cement to the top.
3. File completion forms ACO-1 with K.C.C. within 90 days of well completion, following instructions on ACO-1, side 1, and including copies of wireline logs.
4. Notify District office 48 hours prior to old well workover or re-entry.
5. Prior to plugging, prepare a plugging plan, then obtain agreement from the appropriate district office for an approved plugging plan.
6. Submit plugging report (CP-4) to K.C.C. after plugging is completed.
7. Obtain an approved injection docket number before disposing of salt water.
8. Notify K.C.C. within 10 days when injection commences or terminates.
9. If an alternate 2 completion, cement in the production pipe from below any usable water to surface within 120 days of spud date.

State Corporation Commission of Kansas
Conservation Division
200 Colorado Derby Building
Wichita, Kansas 67202
(316) 263-3238