

SIDE ONE

STATE CORPORATION COMMISSION OF KANSAS
OIL & GAS CONSERVATION DIVISION

WELL COMPLETION OR RECOMPLETION FORM
ACO-1 WELL HISTORY

DESCRIPTION OF WELL AND LEASE

Operator: License # 5263
Name: Midwestern Exploration Co
Address: P.O. Box 1884
City/State/Zip: Liberal, KS 67901

Purchaser: NA - well BE PLUGGED

Operator Contact Person: Harold K. Frauli
Phone: (316) 624-3534

Contractor: License # 5421
Name: Sage Drilling

Wellsite Geologist: Joseph Blair
Phone: (316) 624-2804

Designate Type of Completion
 New Well Re-Entry Workover
 Oil SWD Temp Abd
 Gas Inj Delayed Comp.
 Dry Other (Core, Water Supply etc.)

If OWWO: old well info as follows:
Operator
Well Name
Comp. Date Old Total Depth.....

WELL HISTORY

Drilling Method:
 Mud Rotary Air Rotary Cable
1-28-87 2-7-87 3-10-87
Spud Date Date Reached TD Completion Date
6240' 5817'
Total Depth PBTD

Amount of Surface Pipe Set and Cemented at: 1585 feet
Multiple Stage Cementing Collar Used? Yes No
If yes, show depth set.....feet
If alternate 2 completion, cement circulated from.....feet depth to.....w/.....SX cmt

API No. 15-175-20,944-0000
County: Seward
C. W/2 NE/4 Sec. 11 Twp. 33S Rge. 32 East West

3960 Ft North from Southeast Corner of Section
1980 Ft West from Southeast Corner of Section
(Note: Locate well in section plat below)


Lease Name: McVey Well # 1-11

Field Name:

Producing Formation: NA

Elevation: Ground: 2782 KB: 2794

Section Plat

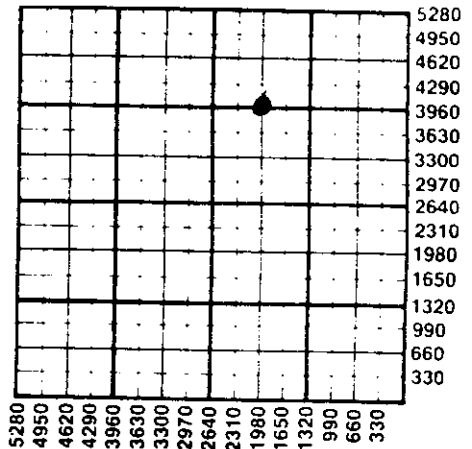

WATER SUPPLY INFORMATION

Disposition of Produced Water: Disposal
Docket # Repressuring

Questions on this portion of the ACO-1 call:

Water Resources Board (913) 296-3717

Source of Water:
Division of Water Resources Permit # T 87-38

Groundwater: 3810 Ft North from Southeast Corner
(Well) 1360 Ft West from Southeast Corner of
Sec 11 Twp 33S Rge 32 East West

Surface Water:Ft North from Southeast Corner
(Stream, pond etc)Ft West from Southeast Corner
Sec Twp Rge East West

Other (explain).....
(purchased from city, R.W.D. #)

INSTRUCTIONS: This form shall be completed in duplicate and filed with the Kansas Corporation Commission, 200 Colorado Derby Building, Wichita, Kansas 67202, within 90 days after completion or recompletion of any well. Rule 82-3-130 and 82-3-107 apply. Information on side two of this form will be held confidential for a period of 12 months if requested in writing and submitted with the form. See rule 82-3-107 for confidentiality in excess of 12 months. One copy of all wireline logs and drillers time log shall be attached with this form. Submit CP-4 form with all plugged wells. Submit CP-111 form with all temporarily abandoned wells.

All requirements of the statutes, rules and regulations promulgated to regulate the oil and gas industry have been fully complied with and the statements herein are complete and correct to the best of my knowledge.

Signature: Harold K. Frauli


Title: Agent Date: 3/26/87

Subscribed and sworn to before me this 27th day of March 1987

Notary Public: Mary Morgan

Date Commission Expires: 8-3-88

K.C.C. OFFICE USE ONLY
 Letter of Confidentiality Attached
 Wireline Log Received
 Drillers Timelog Received
Distribution
 KCC SWD/Rep NGPA
 KGS Plug Other
STATE CORPORATION COMMISSION (Specify)
1987

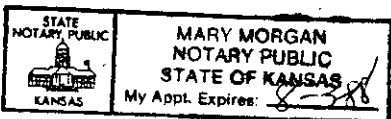

CONSERVATION DIVISION
Wichita, Kansas

03-30-87

Sec 11 Twp 33S Rge 32